


**KANSAS**

Woodson

Section 2 Township 24 Range 15E

Well No. #1 Switzer

Company Ed Dunne

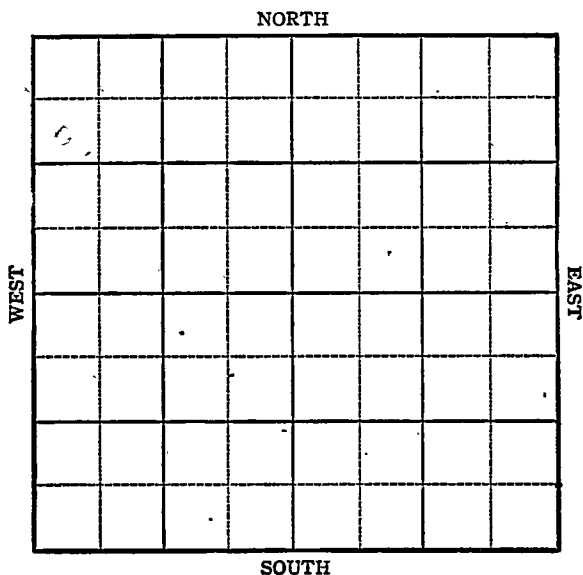

**KANSAS**

Woodson

Sec. 2 Twp. 24 R. 15E

Well No. #1 Switzer Farm

Ed Dunne Company


Miscellaneous

990 Ft. from N. Line

         Ft. from S. Line

         Ft. from E. Line

330 Ft. from W. Line

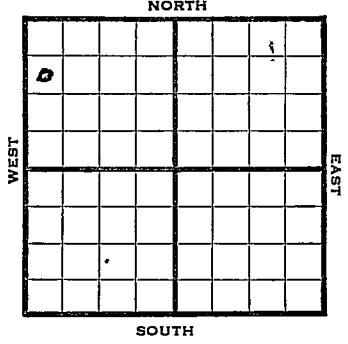

1944

REPORT

- 8/2 10" @ 30  
530' *Drlg.*
- 8/9 Drlg. 970 8" @ 797
- 8/16 Sand 1510 SO 1512  
Drlg. 1516
- 8/23 TD 1517  
Miss. 1485  
6" @ 1490  
2000 acid  
Pump 25 Pot.  
Grav. 36.0

COMPLETED

KANSAS

Pool Name MiscellaneousMap No. 17 Sec. 2 Twp. 24 R. 15EWell No. 1 SwitzerEd Dunne

Company

FIRST REPORT

Contractor

SW NW NW

## SECTION PLAT

990 Ft. from N. Line

Ft. from S. Line

Ft. from E. Line

330 Ft. from W. Line

o			

Woodson County

Location

Rig up

Drilling and Remarks:

10" - 30'

530'

## RECORD

Cased \_\_\_\_\_ in., \_\_\_\_\_ ft.

Sand \_\_\_\_\_

Gas \_\_\_\_\_

Oil \_\_\_\_\_

Total Depth \_\_\_\_\_

## PRODUCTION

1st 24 hrs. Nat. \_\_\_\_\_

1st 24 hrs. after shot \_\_\_\_\_

Gas \_\_\_\_\_ Cu. Ft.

Dry Hole \_\_\_\_\_

Abandoned \_\_\_\_\_

Date

AUG 2 1944 19

S. J. LEVIN Scout

Pool Name Miscellaneous

Map No. 17 Sec. 2 Twp. 24 R. 15E

Well No. 1 Switzer

Ed Dunne Company

**COMPLETED**

Contractor

SW NW NW

**SECTION PLAT**


990 Ft. from N. Line

\_\_\_\_\_ Ft. from S. Line

\_\_\_\_\_ Ft. from E. Line

330 Ft. from W. Line

Woodson County

Location \_\_\_\_\_

Rig up \_\_\_\_\_

Drilling and Remarks:

*Misc 1485*  
*6" @ 1490*  
*2000 acil*  
*Pump 250 x*  
*36 2 1/2*

**RECORD**

Cased \_\_\_\_\_ in., \_\_\_\_\_ ft.

Sand \_\_\_\_\_

Gas \_\_\_\_\_

Oil \_\_\_\_\_

Total Depth 1517

**PRODUCTION**

1st 24 hrs. Nat. \_\_\_\_\_

1st 24 hrs. after shot \_\_\_\_\_

Gas \_\_\_\_\_ Cu. Ft.

Dry Hole \_\_\_\_\_

Abandoned \_\_\_\_\_

Date

AUG 23 1944 19

S. J. LEWIS

Scout