


Map No. _____ Sec. 17 Twp. 29 R. 4

Well No. 2 Groves Farm _____
Ohio Empire Company

NORTH

WEST

EAST

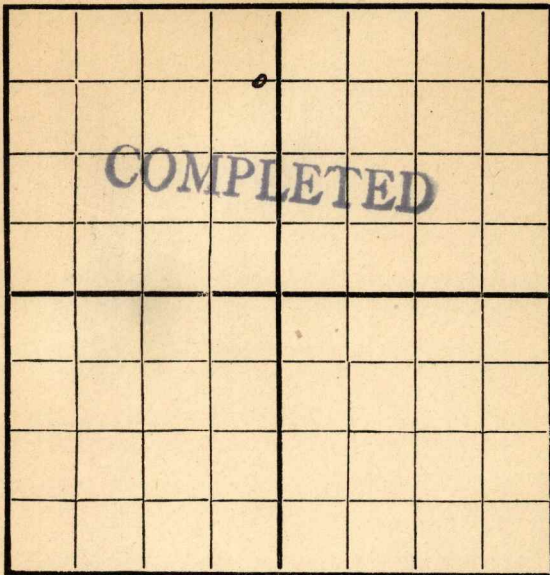

SOUTH

Location _____

Rig Up _____

Drilling Remarks:

Drilling Remarks:

RECORD


PRODUCTION

Cased _____ in _____ Ft.
 Sand _____
 Gas _____
 Oil _____
 Total Depth _____

1st 24 hrs. Nat. _____
 1st 24 hrs. after shot _____
 Gas _____ Cu. Ft.
 Dry Hole _____
 Abandoned _____

Map No. 70 Sec. 17 Twp. 29 R. 4
 Well No. 2 Grove Farm
Oliver Company

NORTH

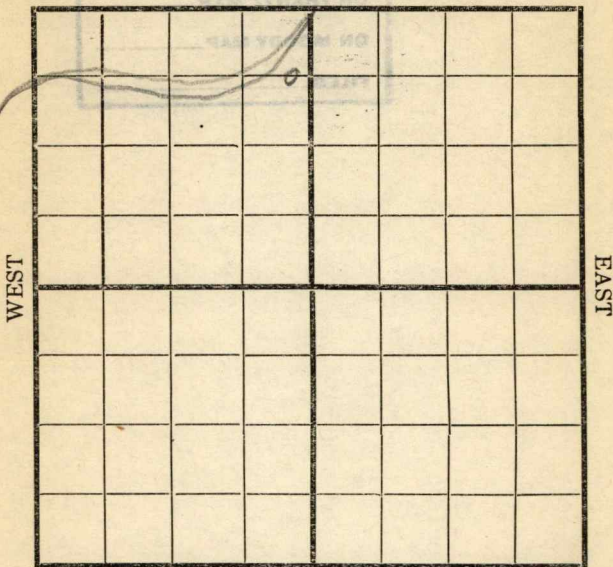

SOUTH

Location ✓
 Rig Up ✓
 Drilling and remarks

FIRST REPORT

RECORD

Cased _____ in. _____ Ft.
 Sand _____
 Gas _____
 Oil _____
 Total Depth _____

PRODUCTION

1st 24 hrs. Nat. _____
 1st 24 hrs. after shot _____
 Gas _____ Cu. Ft.
 Dry Hole _____
 Abandoned _____

Date

5/7, 1917 Cordiff Scout

Map No. _____ Sec. 17 Twp. 29 R. 4
 Well No. 2 _____ Farm _____
Oliver _____ Company _____

NORTH

WEST

EAST

SOUTH

Location _____
 Rig Up ☒
 Drilling and remarks _____

RECORD

Cased _____ in. _____ Ft.
 Sand _____
 Gas _____
 Oil _____
 Total Depth _____

~~FIRST REPORT~~

PRODUCTION

1st 24 hrs. Nat. _____
 1st 24 hrs. after shot _____
 Gas _____ Cu. Ft.
 Dry Hole _____
 Abandoned _____

FIRST REPORT

Date

5/7, 1917 Carly Scout

Map No. _____ Sec. 17 Twp. 29 R. 4Well No. 2 Stone Farm _____Ohio Company _____

NORTH

WEST

EAST

SOUTH

Location _____

Rig Up _____

Drilling and remarks

672

RECORD

Cased _____ in. _____ Ft.

Sand _____

Gas _____

Oil _____

Total Depth _____

PRODUCTION

1st 24 hrs. Nat. _____

1st 24 hrs. after shot _____

Gas _____ Cu. Ft.

Dry Hole _____

Abandoned _____

Date

5/25, 1917 Carley Scout

Map No. _____ Sec. 17 Twp. 29 R. 4Well No. 2 Acres _____ Farm __________
Company _____

NORTH

WEST

EAST

SOUTH

Location _____

Rig Up _____

Drilling and remarks

1025'

RECORD

Cased _____ in. _____ Ft.

Sand _____

Gas _____

Oil _____

Total Depth _____

PRODUCTION

1st 24 hrs. Nat. _____

1st 24 hrs. after shot _____

Gas _____ Cu. Ft.

Dry Hole _____

Abandoned _____


Date

5/29, 191 7Carley Scout

Map No. _____ Sec. 17 Twp. 29 R. 4
Well No. 3 _____ Farm _____
Engine _____ Company _____

NORTH

WEST

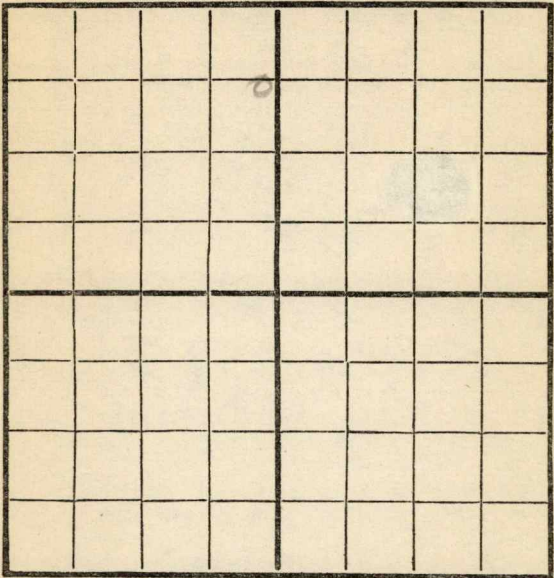

EAST

SOUTH

Location _____
Rig Up _____
Drilling and remarks

1550'

RECORD

Cased _____ in. _____ Ft.
Sand _____
Gas _____
Oil _____
Total Depth _____

PRODUCTION


1st 24 hrs. Nat. _____
1st 24 hrs. after shot _____
Gas _____ Cu. Ft.
Dry Hole _____
Abandoned _____

Date 6/8, 1917, Carroll Scout

Map No. _____ Sec. 17 Twp. 29 R. 4
 Well No. 2 _____ Farm _____
Empire Company

NORTH

WEST

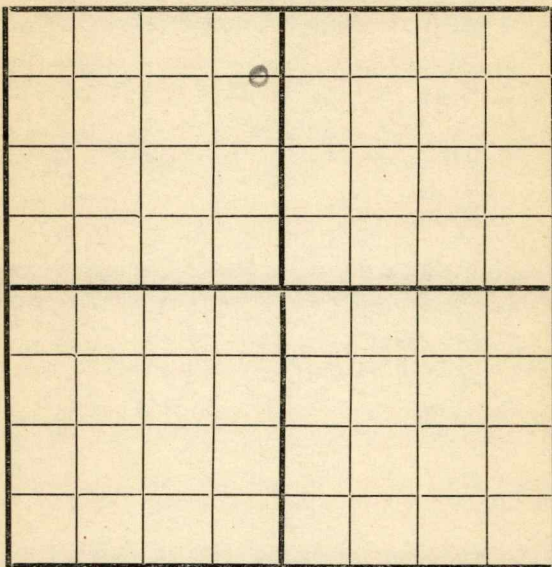

EAST

SOUTH

Location _____

Rig Up _____

Drilling and remarks

1630

RECORD

Cased _____ in. _____ Ft.

Sand _____

Gas _____

Oil _____

Total Depth _____

PRODUCTION

1st 24 hrs. Nat. _____

1st 24 hrs. after shot _____

Gas _____ Cu. Ft.


Dry Hole _____

Abandoned _____

Date

6/12, 1917 Landry Scout

Map No. _____ Sec. 17 Twp. 29 R. 4
 Well No. 2-Graves Farm _____
Cumprine Company _____
 NORTH

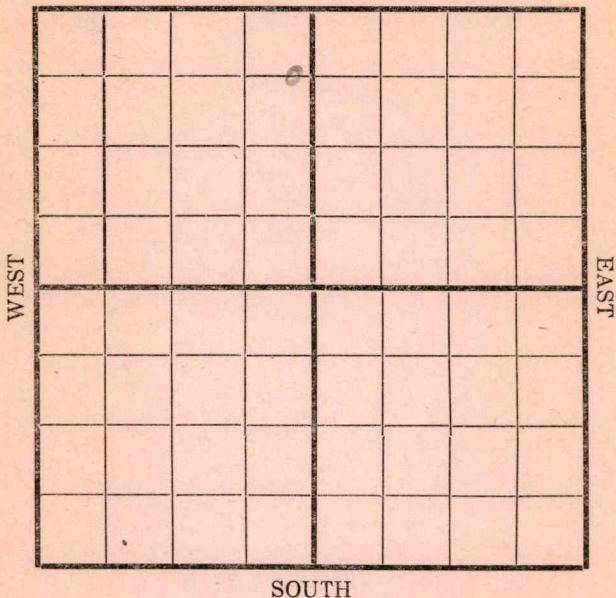

Location _____
 Rig Up _____
 Drilling and remarks _____

RECORD
 Cased _____ in. _____ Ft.
 Sand _____
 Gas _____
 Oil _____
 Total Depth _____

PRODUCTION
 1st 24 hrs. Nat. _____
 1st 24 hrs. after shot _____
 Gas _____ Cu. Ft.
 Dry Hole _____
 Abandoned _____

Date _____

191 7

Scout _____


*Tools hung
 up in hole
 1630*

Map No. _____ Sec. 17 Twp. 29 R. 4
 Well No. 251 Farm _____
Carpenter Company _____

NORTH

WEST

EAST

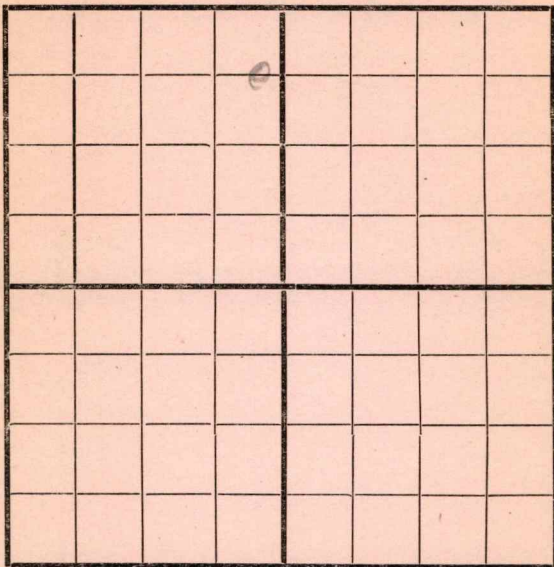

SOUTH

Location _____

Rig Up _____

Drilling and remarks

Fishing
1630

RECORD

Cased _____ in. _____ Ft.

Sand _____

Gas _____

Oil _____

Total Depth _____

PRODUCTION

1st 24 hrs. Nat. _____

1st 24 hrs. after shot _____

Gas _____ Cu. Ft.

Dry Hole _____

Abandoned _____


Date

6/27, 191 *7* *Cardiff* Scout

Map No. _____ Sec. 17 Twp. 29 R. 4
 Well No. 2 _____ Farm _____
Empire _____ Company _____

NORTH

WEST

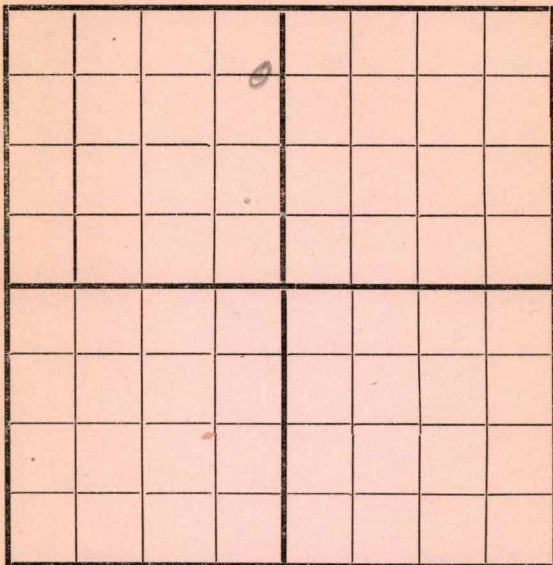

EAST

SOUTH

Location _____
 Rig Up _____
 Drilling and remarks _____

1690

RECORD

Cased _____ in. _____ Ft.
 Sand _____
 Gas _____
 Oil _____
 Total Depth _____

PRODUCTION

1st 24 hrs. Nat. _____
 1st 24 hrs. after shot _____
 Gas _____ Cu. Ft.
 Dry Hole _____
 Abandoned _____


Date

7/6, 1917 Conley Scout

Map No. _____ Sec. 17 Twp. 29 R. 4Well No. 2 Gravel Farm _____Company Cummins

NORTH

WEST

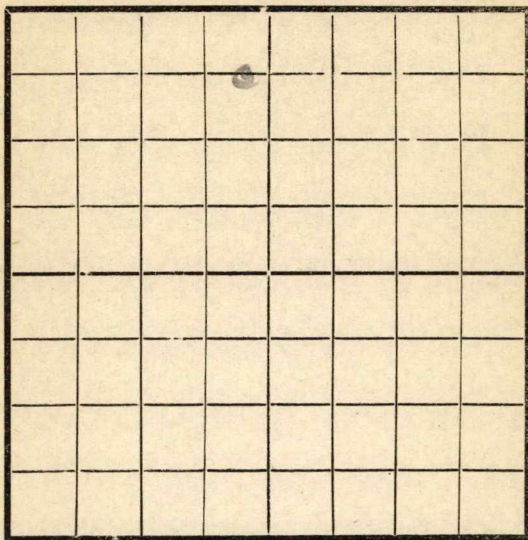

EAST

SOUTH

Location _____

Rig Up _____

Drilling and remarks

dry sand
1835'

RECORD

Cased _____ in. _____ Ft.

Sand _____

Gas _____

Oil _____

Total Depth _____

PRODUCTION

1st 24 hrs. Nat. _____

1st 24 hrs. after shot _____

Gas _____ Cu. Ft.

Dry Hole _____

Abandoned _____


Date

7/11, 191*7* *Cummins* Scout

Map No. _____ Sec. 17 Twp. 29 R. 4Well No. 2 Shores FarmEmpire Company

NORTH

WEST

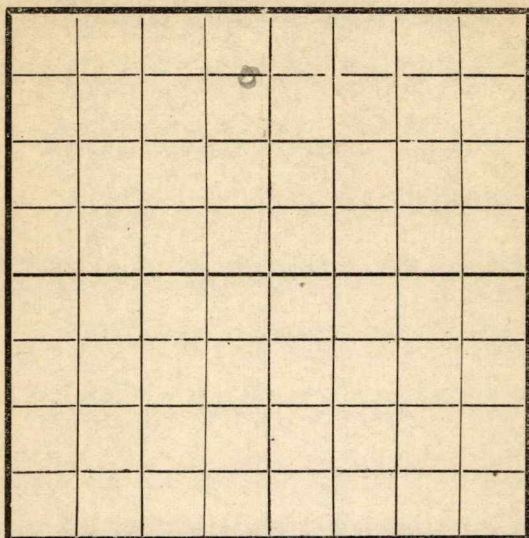

EAST

SOUTH

RECORD

Location _____

Rig Up _____

Drilling and remarks

Cased _____ in. _____ Ft.

Sand _____

Gas _____

Oil _____

Total Depth _____

PRODUCTION

1st 24 hrs. Nat. _____

1st 24 hrs. after shot _____

Gas _____ Cu. Ft.

Dry Hole _____


Abandoned _____

Date

7/27, 1917 Candy Scout

Map No. _____ Sec. 17 Twp. 29 R. 4Well No. 2 Groves Farm __________Empire Company

NORTH

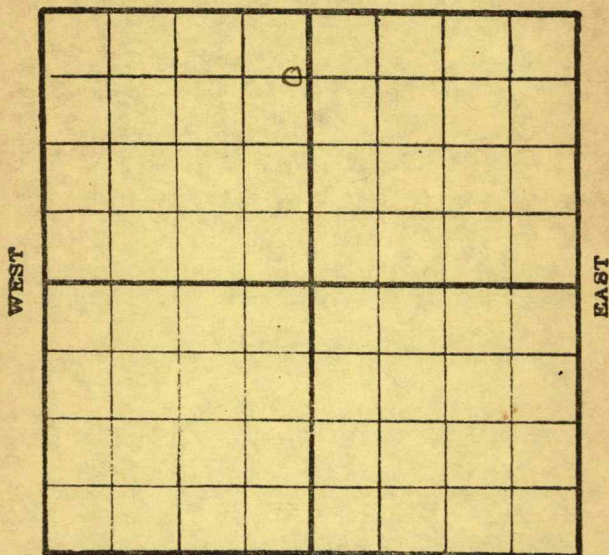

SOUTH

Location _____

Rig up _____

Drilling and remarks:

2475

RECORD

Cased _____ in. _____ Ft.

Sand _____

Gas _____

Oil _____

Total Depth _____

PRODUCTION

1st. 24 hrs. Nat. _____

1st. 24 hrs. after shot. _____

Gas _____ Cu. Ft.

Dry Hole _____

Abandoned _____

Date

7/24, 1917, Carly Scout

Butler
 K 11 **KANSAS** SEC. *17* TWP. *29S* R. *4E*

WELL NO. *2* *Barner*

Empire COMPANY

CONTRACTOR

ABANDONED

SECTION PLAT

	0		

_____ FT. FROM N. LINE

_____ FT. FROM S. LINE

_____ FT. FROM E. LINE

_____ FT. FROM W. LINE

LOCATION _____

RIG UP _____

DRILLING AND REMARKS:

RECORD

CASED _____ IN. _____ FT.

SAND _____

GAS _____

OIL _____

TOTAL DEPTH *2700*

PRODUCTION

1ST 24 HRS. NAT. _____

1ST 24 HRS. AFTER SHOT _____

GAS _____ CU. FT.

DRY HOLE *✓*

ABANDONED *✓*

DATE


July 30 19*17*

SCOUT

Map No. _____ Sec. 17 Twp. 29 R. 4
 Well No. 2 Slaves Farm _____
Empire Company

NORTH

WEST

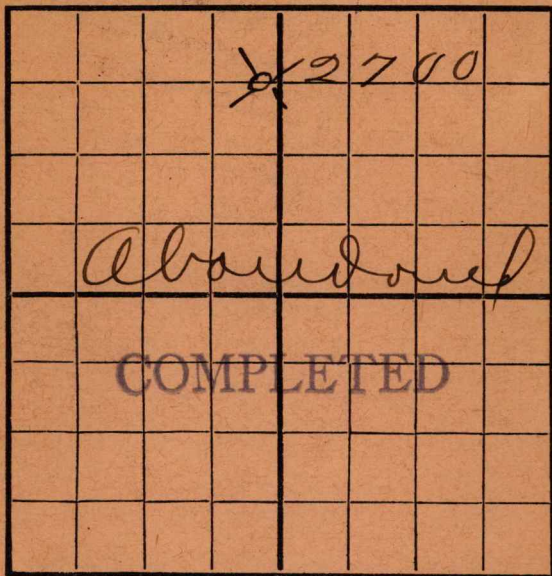

EAST

SOUTH

Location _____
 Rig Up _____
 Drilling and remarks _____

RECORD
 Cased _____ in. _____ Ft.
 Sand _____
 Gas _____
 Oil _____
 Total Depth _____

PRODUCTION
 1st 24 hrs. Nat. _____
 1st 24 hrs. after shot _____
 Gas _____ Cu. Ft.
 Dry Hole _____
 Abandoned _____

Date

8/1, 1917 Cardiff Scout