


Woodson

Section 3 Township 24 Range 15-E

Well No. 1 Freeburg

Company Harper & Duncan

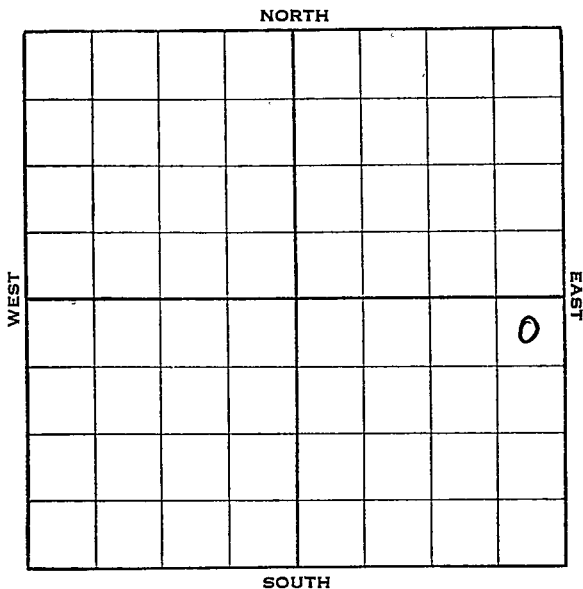

KANSAS

Woodson

Sec. **3** Twp. **24** R. **15-E**

Well No. **#1 Freeburg** Farm


Harper & Duncan Company

330 Ft. from N. Line

Ft. from S. Line

330 Ft. from E. Line

Ft. from W. Line

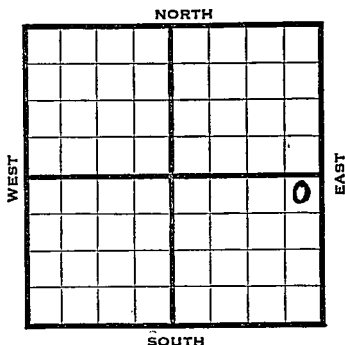

1938	REPORT
6/8	8" at 795'.
	Drlg. 1310'.
6/15	6" @ 1500'.
	Miss. 1500'.
	T.D. 1547'.
	No shows.
	ABANDONED

Map No. 17 Sec. 3 Twp. 24 R. 15EWell No. 1 FreeburgHarper & Duncan

Company

Contractor

FIRST REPORT

SECTION PLAT

NE SE
330 Ft. from N. Line
 _____ Ft. from S. Line
330 Ft. from E. Line
 _____ Ft. from W. Line

			0

Location _____

Rig up _____

Drilling and Remarks:
8" - 795

Drlg. 1310

RECORD

Cased _____ in., _____ ft.

Sand _____

Gas _____

Oil _____

Total Depth _____

PRODUCTION

1st 24 hrs. Nat. _____

1st 24 hrs. after shot _____

Gas _____ Cu. Ft.

Dry Hole _____

Abandoned _____

Date

JUN 8 - 1938 19

H. D. Hatfield Scout

