


KANSAS Barton County

FORM 51 5M PETROL

Section 10 Township 19 Range 15W

Well No. 3 Seeber

Company Helmerick & Payne

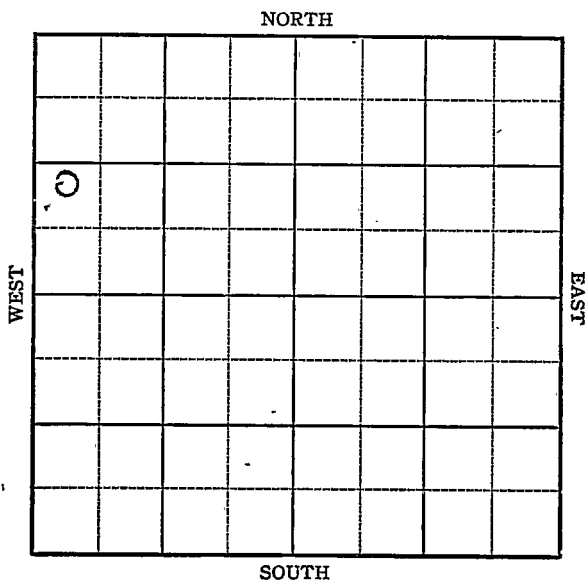

KANSAS

Barton

Sec. 10 Twp. 19 R. 15W

Well No. 3 Seeber Farm

Helmerick & Payne Company


Mertens

\_\_\_\_\_ Ft. from N. Line

990 Ft. from S. Line

\_\_\_\_\_ Ft. from E. Line

330 Ft. from W. Line

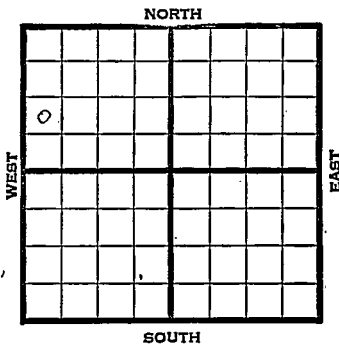

NW SW NW Elev. 1966

1945

REPORT

6/13 Location  
 6/21 Derrick  
 6/28 Anhy 920  
 10" @ 930 WOC

7/3 Drlg. 2435  
 7/11 Drlg. 3332'  
 7/19 Lans 3231  
 Pre Comb 3470  
 TD 3509  
 5" @ 3430' RUST  
 7/26 " " "  
 8/1 Basal 3470  
 5" @ 3430'  
 T.D. 3509'

**ABANDONED**

Kansas Pool Name Mertens

Map No. 82 Sec. 10 Twp. 19 R. 15W

Well No. 3 Seeber

Helmerick & Payne Company

**FIRST REPORT**

Contractor

NW SW NW

**SECTION PLAT**

\_\_\_\_\_ Ft. from N. Line

990 Ft. from S. Line

\_\_\_\_\_ Ft. from E. Line

330 Ft. from W. Line

o			

Barton County

Location X

Rig up \_\_\_\_\_

Drilling and Remarks:

**RECORD**

Cased \_\_\_\_\_ in., \_\_\_\_\_ ft.

Sand \_\_\_\_\_

Gas \_\_\_\_\_

Oil \_\_\_\_\_

Total Depth \_\_\_\_\_

**PRODUCTION**

1st 24 hrs. Nat. \_\_\_\_\_

1st 24 hrs. after shot \_\_\_\_\_

Gas \_\_\_\_\_ Cu. Ft.

Dry Hole \_\_\_\_\_

Abandoned \_\_\_\_\_

Date

JUN 13 1945

19

S. J. LEWIS

Scout

