

KANSAS

Form 51-5M-7-40-Palace


Butler

Section 17 Township 29 Range 4-E

Well No. #2 Piper

Company Simpson Oil

NORTH Douglas Pool

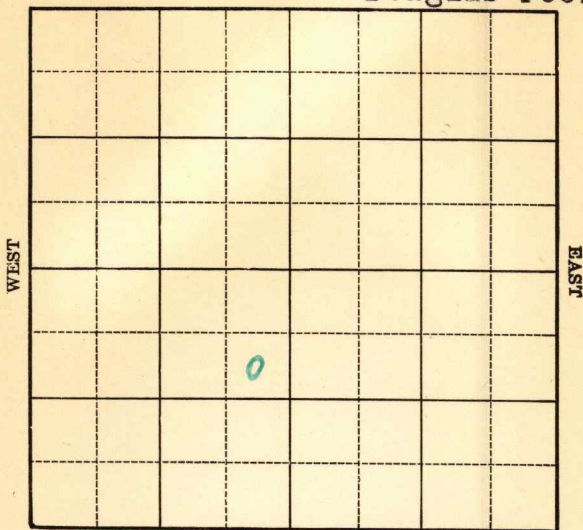

SOUTH

Map No. 11 Sec. 17 Twp. 29 R. 4E

Well No. 2 Piper

Simpson Oil

Company

Contractor

FIRST REPORT

SE NE SW

SECTION PLAT

990 Ft. from N. Line

Ft. from S. Line

330 Ft. from E. Line

Ft. from W. Line

DOUGLAS POOL

Location _____

RECORD

Rig up _____

Cased _____ in., _____ ft.

Drilling and Remarks:

Sand _____

Machine

Gas _____

Oil _____

Total Depth _____

PRODUCTION

1st 24 hrs. Nat. _____

1st 24 hrs. after shot _____

Gas _____ Cu. Ft.

Dry Hole _____

Abandoned _____

Date

AUG 7 1940 19

S. J. LEWIS Scout

Map No. 11 Sec. 17 Twp. 29 R. 4E

Well No. 2 Piper

Simpson Oil Company

Contractor

ABANDONED

SECTION PLAT

SE NE SW

990 Ft. from N. Line

_____ Ft. from S. Line

330 Ft. from E. Line

_____ Ft. from W. Line

DOUGLAS POOL

Location _____

Rig up _____

Drilling and Remarks:

Lans 1845-

6" @ 1845-

No shows.

RECORD

Cased _____ in., _____ ft.

Sand _____

Gas _____

Oil _____

Total Depth 1982

PRODUCTION

1st 24 hrs. Nat. _____

1st 24 hrs. after shot _____

Gas _____ Cu. Ft.

Dry Hole _____

Abandoned _____

Date

SEP 4 1940 19

S. J. LEWIS Scout