


Section 17 Township 29 Range 4E

Well No. 2 Piper

Company D. E. Piper

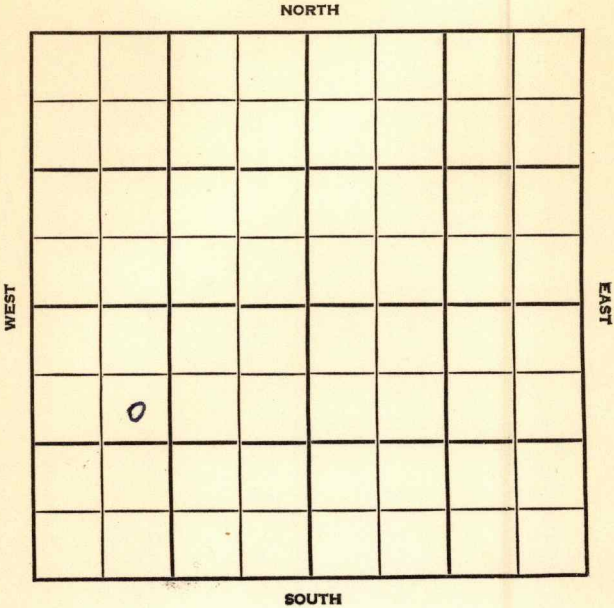

Butler

KANSAS

SEC.	TWP.	R.
17	29	4E ✓

WELL NO.

#2 Piper

FARM

COMPANY

D.E. Piper

CONTRACTOR

White & Ellis

Douglas Pool NORTH

990

Ft. from N. Line


Ft. from S. Line

Ft. from E. Line

990

Ft. from W. Line

SE NW SW

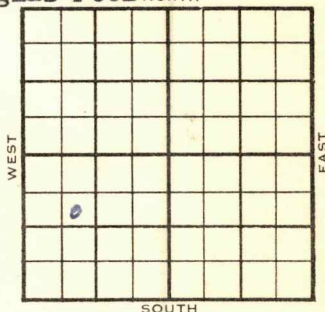

	ELEVATION	REPORT
1954	1183	

5/12

Spud 5-9-54

8" @ 98'

WOC.

6/9

Spudding 5-9-54

Oilwell

TD 1871

8" @ 98

Lans. 1841

TD 1853

5" @ 1852

DD 1871 FU 70' oil 10 hr. S/7 boph

3 hr. Comp 25 bopd.

COMPLETED

County **Butler** State **Kansas**
Sec. **17** (Blk. **29** (Sur. **4E** Map No.
Operator **D. E. Piper**
Well No. **2** Farm **Piper**
Elev. Location **SE NW SW**

0
FIRST REPORT

990 Ft. From **N** Line **SW**
990 Ft. From **W** Line Quarter
1st. Report **MAY 12 1954**
Completion
Remarks **White & Ellis - Contr.**
Spudding Date **5-9-54**

Drlg. Data

Douglas Pool**8" @ 98 WOC**

County Butler State Kansas

Sec. 17 (Blk.) 29 (Sur.) 4E Map No.

Operator D. E. Piper

Well No. 2 Farm Piper

Elev.	1183	Location	SE NW SW
-------	------	----------	----------

COMPLETE

990 Ft. From N Line SW

990 Ft. From W Line Quarter

1st. Report

Completion JUN 9 1954

Remarks Douglas Pool

White & Ellis - Contr.

Spudding Date 5-9-54

Drlg. Data Oilwell TD 1871

8" @ 98 Lans. 1841 TD 1853 5" @ 1852

DD 1871 FU 70' oil 10 hr. S/ 7 boph

3 hr. Comp. 25 bopd

J. G. McGEHEE