


Section 18 Township 29 Range 4E

Well No. #1 Alexander

Company White & Ellis

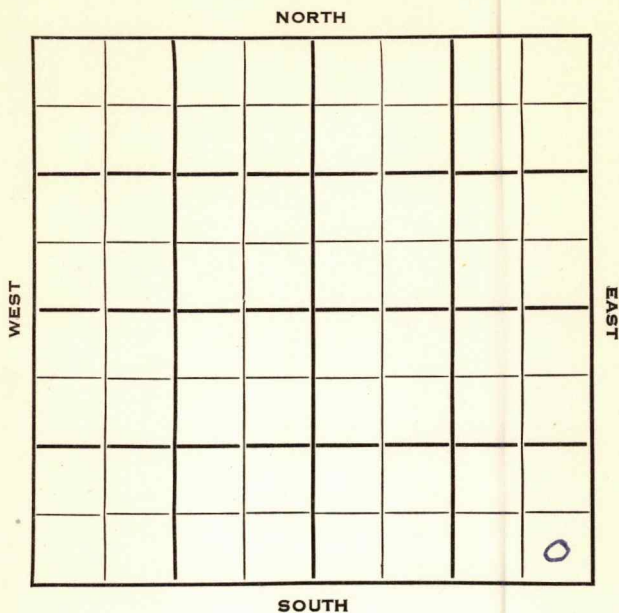

Sec. 18 Twp. 29 R. 4E

Well No. #1 Alexander Farm

White & Ellis Company

White & Ellis Contractor
Douglas Pool


_____ Ft. from N. Line

330 Ft. from S. Line

330 Ft. from E. Line

_____ Ft. from W. Line

SE SE SE

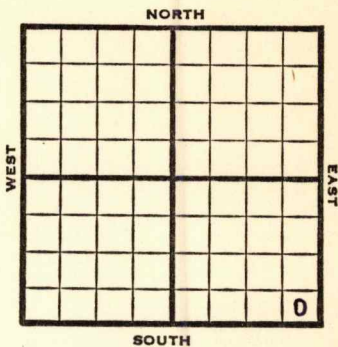

1953

Elev. 1185'

REPORT

5/6

Spud 5-1-53

8" @ 90

Lans 1871

TD 1907

5" @ 1902

WOC

6/3

Spud 5-1-53

D&A

TD 1910

8" @ 90

Lans 1871

TD 1907

5" @ 1902

DD 1910

1000A

D&A

ABANDONED

