

Ellsworth 10W

Section 36 Township 17 Range \_\_\_\_\_  
1 Sturn "B"

Well No. \_\_\_\_\_

Company Shields Oil

NORTH

8

WEST

						D	

EAST

SOUTH

Sec. 36 Twp. 17 R. 10 W

Well No. # 1 Sturn-"B" Farm \_\_\_\_\_

Shields Oil Company \_\_\_\_\_

Shields Contractor \_\_\_\_\_


\_\_\_\_\_ Ft. from N. Line

990 Ft. from S. Line

990 Ft. from E. Line

\_\_\_\_\_ Ft. from W. Line

NW SE NE

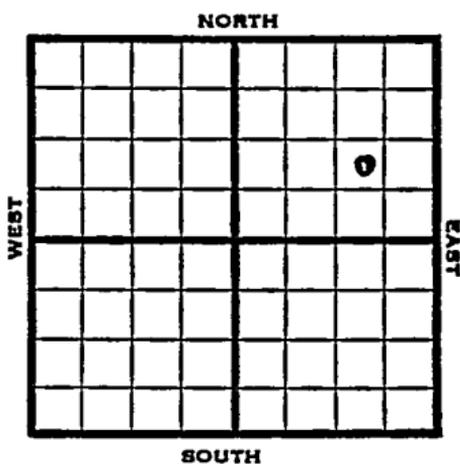

1952

Elev. 1772' REPORT

12/17

Spud 12-7-52  
8" @ 258 Anhy 485'  
Drlg. 2895'

12/25

Drlg 2895

1/1

KC 2900 Arb 3258 RTD 3258 5" @ 3258

1/8

DD 3265 500A 50 / wtr Plug 3254  
12/3240-42 s/7 BO / 50 BW Plug 3224  
11/3214-16 SO & Lot wtr sq off.

1/22

CO 3224' 39/3216-3221  
S/8 BFPH 20 hrs. 50% wtr.

1/29

NR

2/5

NR

2/12

P/31 BOPD plus 45% wtr.

2/19

NR

2/26

"

3/11

Spud 12-7-52 Oil well TD 3265  
8" @ 258 Anhy 485 KC 2900  
Arb. 3258  
DST 3210-22 open 1 hr. rec 1500' oil  
120' wtr. 750#  
DST 3224-34 open 1 hr. rec 120' gas,  
120' HOCM, 320' O & G & W 855#  
TD 3258 5" @ 3258 DD 3265

OVER

1953  
3/11

(Information continued)

500 A SO & wtr. SP 3254

12/3240-42 S/7 BO 50 BW SP 3234

11/3214-16 SO & lot wtr. Sq.

GO to 3224 39/3216-21 S/8 BFPH

20 hr. 50% wtr.

P/31 BOPD 45% wtr.

Comp. 77 BOPD 49% wtr.

**COMPLETED**



