

KANSAS


Ellsworth

FORM 51 5M 2-38 TPCO.

Section 33 Township 17 Range 10-W

Well No. #2 Gain - Stumps

Company Transwestern

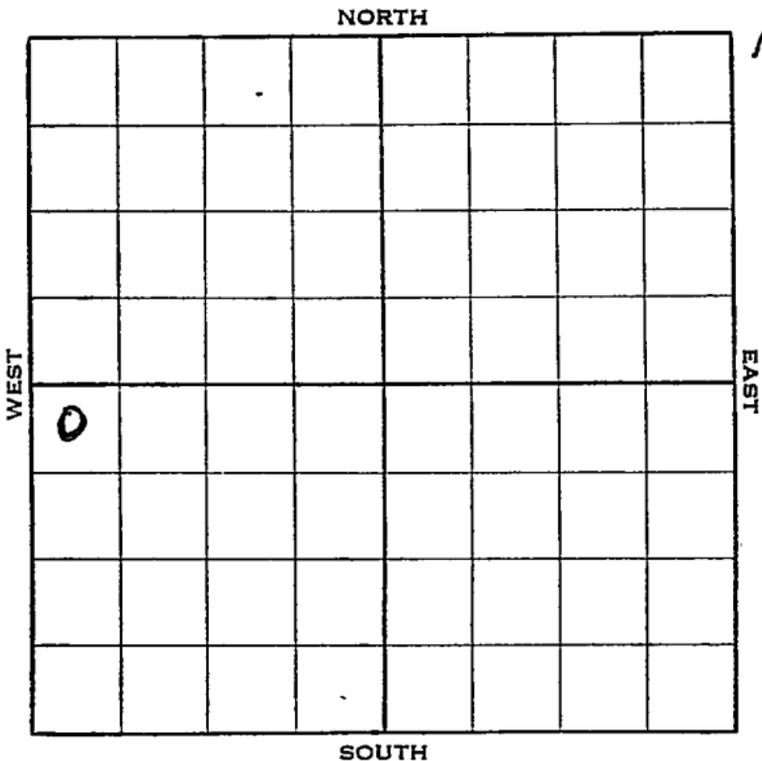

Sec. 33 Twp. 17^N R. 10-W

Well No. #2 Cain - Stumps Farm

Transwestern Company


330 Ft. from N. Line

_____ Ft. from S. Line

_____ Ft. from E. Line

330 Ft. from W. Line

Elev. 1796

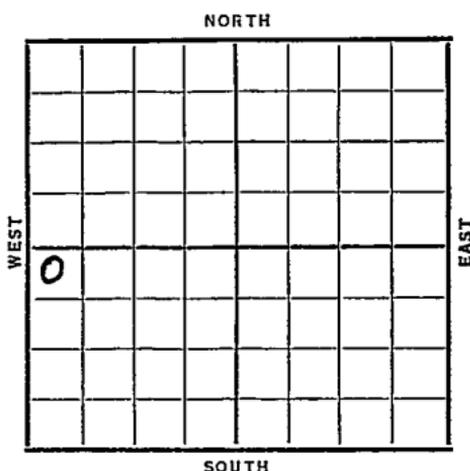

Date	REPORT
1938	
10/19	R. R.
10/28	R. R.
11/4	"
11/12	10" - 261'. Dlg. 1420'.
11/18	Drilg. 2730'.
11/25	Lans. 2942'. Arb. 3229'.
	S. O. 3249-51' T.D.
	7" - 3248'. RUST.
11/30	7" - 3248'.
	Arb. 3229'.
	T. D. 3271'.
	Pump 699 bbls. 8 hrs. No water.
	Potential 2098 bbls. Nat.
	COMPLETED

Ellsworth KANSAS

Map No. _____ Sec. 33 Twp. 17 R. 10WWell No. 2 Cain - StumpsTranswestern Company

Contractor

FIRST REPORT

NW SW

330 Ft. from N. Line

_____ Ft. from S. Line

_____ Ft. from E. Line

330 Ft. from W. Line

SECTION PLAT

0			

Location _____

Rig up _____

Drilling and Remarks:

RR

RECORD

Cased _____ in., _____ ft.

Sand _____

Gas _____

Oil _____

Total Depth _____

PRODUCTION

1st 24 hrs. Nat. _____

1st 24 hrs. after shot _____

Gas _____ Cu. Ft.

Dry Hole _____

Abandoned _____

Date

OCT 19 1938 19

H. D. Hatfield

Scout

Map No. 53 Sec. 33 Twp. 17 R. 10WWell No. 2 Gain-StumpsTranswestern Company

Contractor

COMPLETED

NW SW

330 Ft. from N. Line

_____ Ft. from S. Line

_____ Ft. from E. Line

330 Ft. from W. Line

SECTION PLAT

0			

Location _____

Rig up _____

Drilling and Remarks: _____

RECORD

Cased 7 in., 3248 ft.Sand Arb 3229

Gas _____

Oil _____

Total Depth 3271Pump $699\frac{1}{2}$ No wtr

Pot 2098

Nat.

PRODUCTION

1st 24 hrs. Nat. _____

1st 24 hrs. after shot _____

Gas _____ Cu. Ft.

Dry Hole _____

Abandoned _____

Date

NOV 30 1938

19

H. D. Hatfield Scout