

# KANSAS

FORM 51 5M 4-41 PETROL


## Ellsworth

Section 33 Township 17 Range 10-W

Well No. 2 Stumps

Company Braine & Goering

NORTH Bloomer pool

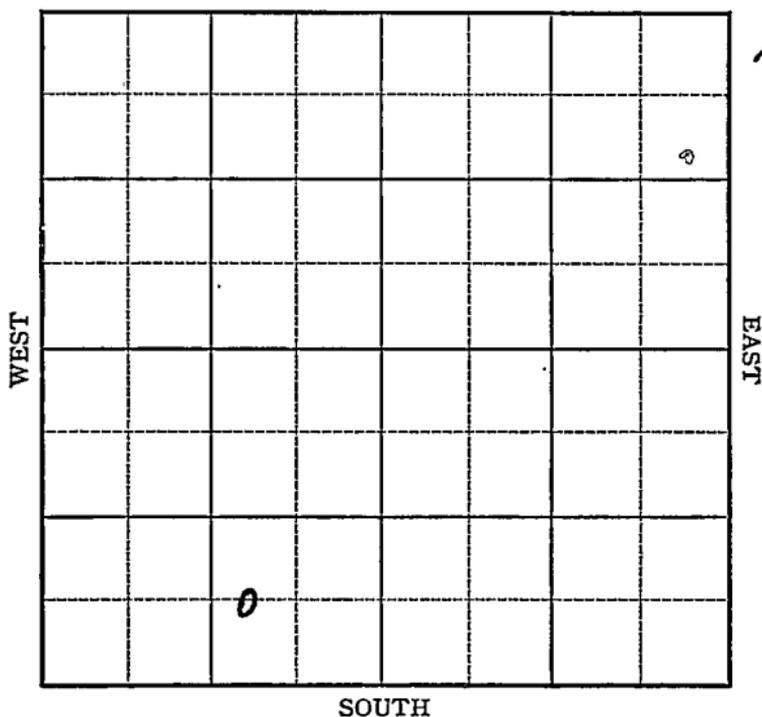

Sec. 33 Twp. 17 R. 10-W

Well No. #2 Stumps Farm

Braine & Goering Company


(Bloomer)

\_\_\_\_\_ Ft. from N. Line

660 Ft. from S. Line

990 Ft. from E. Line

\_\_\_\_\_ Ft. from W. Line

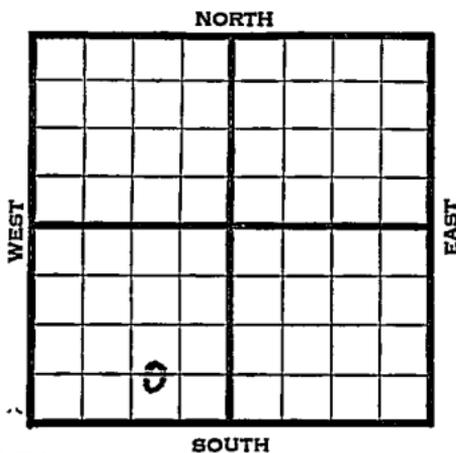

Elev. 1794

| 1941 | REPORT                          |
|------|---------------------------------|
| 8/20 | Derrick.                        |
| 8/28 | 10" - 333' Drlg. 1530'          |
| 9/4  | Arb. 3242-45' T.D. 5" - 3243'   |
|      | RUST.                           |
| 9/11 | T.D. 3263' 1600' oil 11½ hours. |
| 9/17 | Arb. 3242'                      |
|      | 5" - 3243'                      |
|      | T.D. 3263'                      |
|      | 6000 acid.                      |
|      | 1360 Butane.                    |
|      | Potential 451 bbls., pump.      |
|      | 42.6 Gravity                    |
|      | <b>COMPLETED</b>                |
|      |                                 |
|      |                                 |
Map No. 55 Sec. 33 Twp. 17 R. 10W

Well No. 2 Stumps

Braine & Goering Company

FIRST REPORT Contractor

C W L SE SW

**SECTION PLAT**

\_\_\_\_\_ Ft. from N. Line

660 Ft. from S. Line

990 Ft. from E. Line

\_\_\_\_\_ Ft. from W. Line

|  |  |  |  |
|--|--|--|--|
|  |  |  |  |
|  |  |  |  |
|  |  |  |  |
|  |  |  |  |

BLOOMER POOL

Location \_\_\_\_\_

**RECORD**

Rig up \_\_\_\_\_

Cased \_\_\_\_\_ in., \_\_\_\_\_ ft.

Drilling and Remarks:

Sand \_\_\_\_\_

Derrick

Gas \_\_\_\_\_

Oil \_\_\_\_\_

Total Depth \_\_\_\_\_

**PRODUCTION**

1st 24 hrs. Nat. \_\_\_\_\_

1st 24 hrs. after shot \_\_\_\_\_

Gas \_\_\_\_\_ Cu. Ft.

Dry-Hole \_\_\_\_\_

Abandoned \_\_\_\_\_

Date

AUG 20 1941

S. I. LEWIS Scout

Map No. \_\_\_\_\_ Sec. 33 Twp. 17 R. 10W

Well No. 2 Stumps

Braine & Goering Company

**COMPLETED** Contractor

**SECTION PLAT**

C W L SE SW  
\_\_\_\_\_ Ft. from N. Line  
660 Ft. from S. Line  
990 Ft. from E. Line  
\_\_\_\_\_ Ft. from W. Line

|  |   |  |  |
|--|---|--|--|
|  |   |  |  |
|  |   |  |  |
|  |   |  |  |
|  | 0 |  |  |

**BLOOMER POOL**

**RECORD**

Location \_\_\_\_\_

Cased \_\_\_\_\_ in., \_\_\_\_\_ ft.

Rig up \_\_\_\_\_

Sand \_\_\_\_\_

Drilling and Remarks:

Gas \_\_\_\_\_

Oil \_\_\_\_\_

Total Depth 3269

*Ce 83242  
5" @ 3249  
6000 acid  
1360 Bator v.  
Purif 451 Pot.  
426 hr*

**PRODUCTION**

1st 24 hrs. Nat. \_\_\_\_\_

1st 24 hrs. after shot \_\_\_\_\_

Gas \_\_\_\_\_ Cu. Ft.

Dry Hole \_\_\_\_\_

Abandoned \_\_\_\_\_

Date

SEP 17 1941 19

**S. J. LEWIS** Scout