

# KANSAS


Ellsworth

FORM 51 5M 4-41 PETROL

Section 33 Township 17 Range 10W

Well No. 3 Stumps

Company Braine & Goering

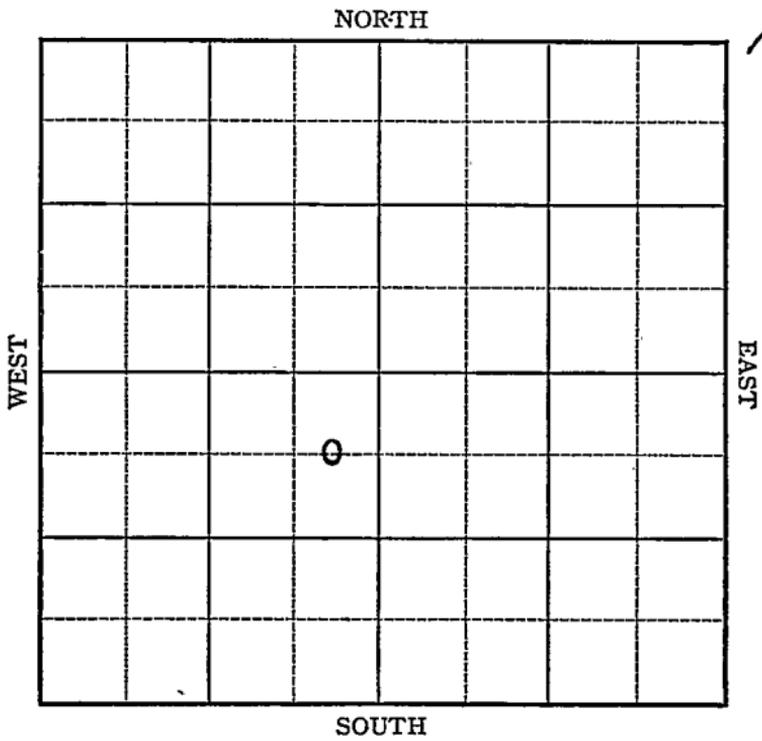

Sec. 33 Twp. 17 R. 10-W

Well No. #3 Stumps Farm

Braine & Goering Company


(Bloomer)

660 Ft. from N. Line

\_\_\_\_\_ Ft. from S. Line

330 Ft. from E. Line

\_\_\_\_\_ Ft. from W. Line

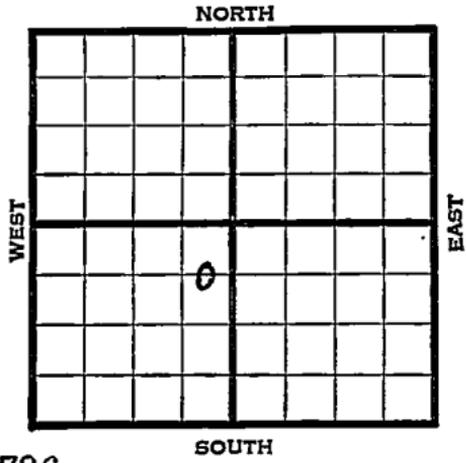

Elev. 1786

1941	REPORT
9/3	R.U.R.
9/11	8" - 295' Drlg. 1900'
9/18	Lans. 2925' Cong. 3227'
	Arb. 3230-33' T.D.
	5" - 3232' RUST.
9/25	T.D. 3259' 1900' oil 13 hrs.
	3000 acid.
10/1	Arb. 3230'
	5" - 3232'
	T.D. 3259'
	3000 acid.
	Potential 392 bbls., pump.
	43.1 Gravity
	<b>COMPLETED</b>

Map No. \_\_\_\_\_ Sec. 33 Twp. 17 R. 10WWell No. 3 StumpsBraine & Goering CompanyFIRST REPORT Contractor

## SECTION PLAT

C E L N E S W

660 Ft. from N. Line

\_\_\_\_\_ Ft. from S. Line

330 Ft. from E. Line

\_\_\_\_\_ Ft. from W. Line

BLOOMER POOL


Location \_\_\_\_\_

Rig up \_\_\_\_\_

Drilling and Remarks:

RUR

## RECORD

Cased \_\_\_\_\_ in., \_\_\_\_\_ ft.

Sand \_\_\_\_\_

Gas \_\_\_\_\_

Oil \_\_\_\_\_

Total Depth \_\_\_\_\_

## PRODUCTION

1st 24 hrs. Nat. \_\_\_\_\_

1st 24 hrs. after shot \_\_\_\_\_

Gas \_\_\_\_\_ Cu. Ft.

Dry Hole \_\_\_\_\_

Abandoned \_\_\_\_\_

Date

SEP 3 1941 19S. J. LEWIS Scout

**KANSAS**

Map No. K-55 Sec. 33 Twp. 17 R. 10W

Well No. 3 Stumps

Brine & Goering Company

COMPLETED Contractor

**SECTION PLAT**

C E L N E S V

	o		

660 Ft. from N. Line

\_\_\_\_\_ Ft. from S. Line

330 Ft. from E. Line

\_\_\_\_\_ Ft. from W. Line

BLOOMER POOL

**RECORD**

Location \_\_\_\_\_

Cased \_\_\_\_\_ in., \_\_\_\_\_ ft.

Rig up \_\_\_\_\_

Sand \_\_\_\_\_

Drilling and Remarks:

Gas \_\_\_\_\_

*Dr Y3230*

Oil \_\_\_\_\_

*5" C3232.*

Total Depth 3257

*3000 acial*

*Pump 392 P.D.*

**PRODUCTION**

1st 24 hrs. Nat. \_\_\_\_\_

1st 24 hrs. after shot \_\_\_\_\_

Gas \_\_\_\_\_ Cu. Ft.

Dry Hole \_\_\_\_\_

Abandoned \_\_\_\_\_

*43 1/2*

Date

OCT 1 1941 19

**S. J. LEWIS**

Scout