

# KANSAS

Ellsworth

FORM 51 5M 4-41 PETROL


Section 33 Township 17 Range 10-W

Well No. #3 C. Stumps

Company Transwestern et al

Bloomer pool

NORTH

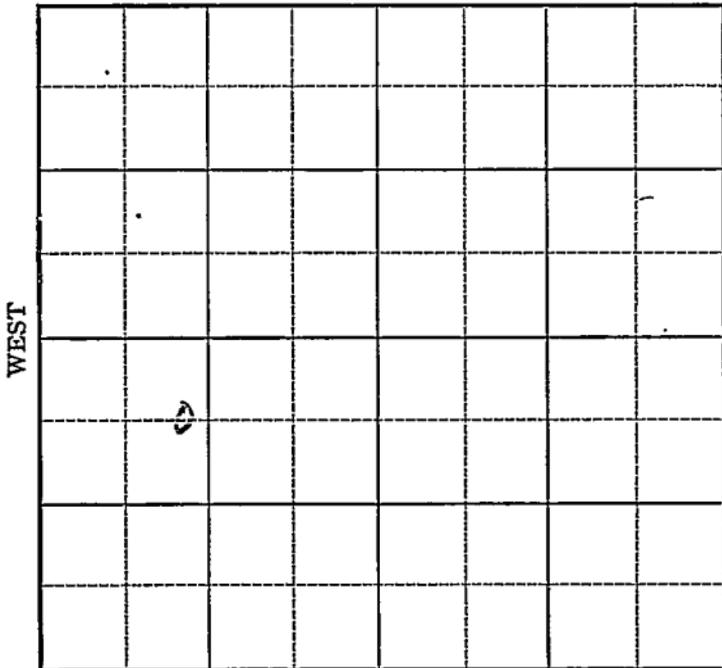

SOUTH

Sec. 33 Twp. 17 R. 10-W

Well No. #3 C. Stumps Farm

Transwestern et al Company


(Bloomer)

660 Ft. from N. Line

\_\_\_\_\_ Ft. from S. Line

\_\_\_\_\_ Ft. from E. Line

990 Ft. from W. Line

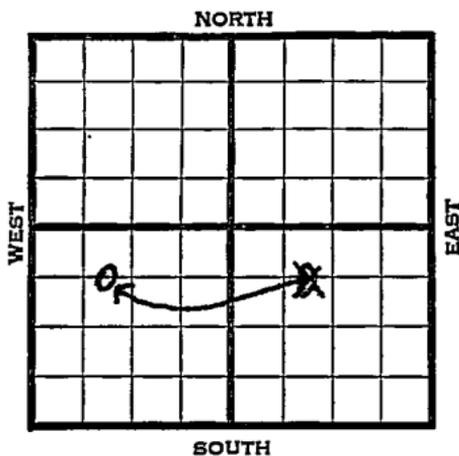

Elev. 1794

1941	REPORT
8/27	R.O.G.
9/4	Drlg. 1940'
9/11	10" - 260' Lans. 2946'
	Cong. 3228' Arb. 3241-43' T.D.
	Run casing.
9/18	8" - 3243' T.D. 3265'
	400' oil 2 hours. Shut down.
9/24	Arb. 3241'
	8" - 3243'
	T.D. 3265'
	4000 acid.
	Echometer potential 2584 bbls.
	42.6 Gravity
	<b>COMPLETED</b>

Map No. \_\_\_\_\_ Sec. 33 Twp. 17 R. 10W

Well No. 3 C. Stumps

Transwestern etal Company

FIRST REPORT Contractor

C E L N W S E

660 Ft. from N. Line

\_\_\_\_\_ Ft. from S. Line

\_\_\_\_\_ Ft. from E. Line

990 Ft. from W. Line

**SECTION PLAT**

		0	

BLOOMER POOL

Location \_\_\_\_\_

Rig up \_\_\_\_\_

Drilling and Remarks:

ROG

**RECORD**

Cased \_\_\_\_\_ in., \_\_\_\_\_ ft.

Sand \_\_\_\_\_

Gas \_\_\_\_\_

Oil \_\_\_\_\_

Total Depth \_\_\_\_\_

**PRODUCTION**

1st 24 hrs. Nat. \_\_\_\_\_

1st 24 hrs. after shot \_\_\_\_\_

Gas \_\_\_\_\_ Cu. Ft.

Dry Hole \_\_\_\_\_

Abandoned \_\_\_\_\_

Date

AUG 27 1941

19

S. J. LEWIS

Scout

Map No. \_\_\_\_\_ Sec. 33 Twp. 17 R. 10W

Well No. 3 C. Stumps

Transwestern et al Company

CORRECTION Contractor

C E L NW SW

SECTION PLAT

660 Ft. from N. Line

\_\_\_\_\_ Ft. from S. Line

\_\_\_\_\_ Ft. from E. Line

990 Ft. from W. Line

0			

BLOOMER POOL

Location \_\_\_\_\_

Rig up \_\_\_\_\_

Drilling and Remarks:

Reported

C E L NW SE

RECORD

Cased \_\_\_\_\_ in., \_\_\_\_\_ ft.

Sand \_\_\_\_\_

Gas \_\_\_\_\_

Oil \_\_\_\_\_

Total Depth \_\_\_\_\_

PRODUCTION

1st 24 hrs. Nat. \_\_\_\_\_

1st 24 hrs. after shot \_\_\_\_\_

Gas \_\_\_\_\_ Cu. Ft.

Dry Hole \_\_\_\_\_

Abandoned \_\_\_\_\_

Date

SEP 3 1941 19

S. J. LEWIS Scout

Map No. 4-55 Sec. 33 Twp. 17 R. 10W

Well No. 3 C. Stumps

Transwestern etal Company

COMPLETED Contractor

C E L NW SW

**SECTION PLAT**

660 Ft. from N. Line

\_\_\_\_\_ Ft. from S. Line

\_\_\_\_\_ Ft. from E. Line

990 Ft. from W. Line

o			

BLOOMER POOL

Location \_\_\_\_\_

**RECORD**

Rig up \_\_\_\_\_

Cased \_\_\_\_\_ in., \_\_\_\_\_ ft.

Drilling and Remarks:

Sand \_\_\_\_\_

*Oil 3241*

Gas \_\_\_\_\_

*8" @ 3248*

Oil \_\_\_\_\_

*4000 acid*

Total Depth 3265

*Echo Rd 2084*

**PRODUCTION**

1st 24 hrs. Nat. \_\_\_\_\_

1st 24 hrs. after shot \_\_\_\_\_

Gas \_\_\_\_\_ Cu. Ft.

Dry Hole \_\_\_\_\_

Abandoned \_\_\_\_\_

*42 @ Gr*

Date

SEP 24 1941 19

S. J. LEWIS Scout