

Section 33 Township 17 Range 10-W

Well No. 4 Stumps


Company Braine & Goering

Bloomer pool

NORTH

WEST

EAST

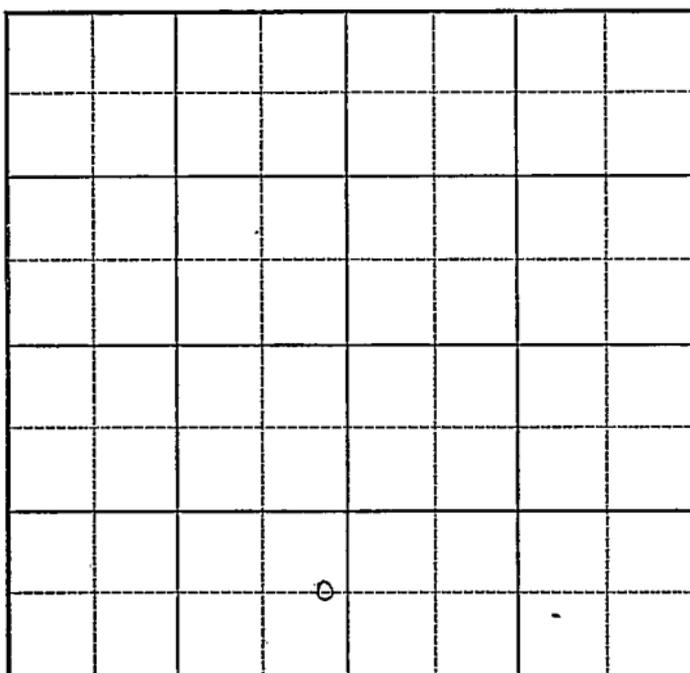

SOUTH

14

Map No. _____ Sec. 33 Twp. 17 R. 10WWell No. 4 StumpsBraine & Goering Company**FIRST REPORT** Contractor

C E L S E S W

SECTION PLAT

_____ Ft. from N. Line

660 Ft. from S. Line330 Ft. from E. Line

_____ Ft. from W. Line

BLOOMER POOL

RECORD

Location _____

Rig up _____

Drilling and Remarks:

Cased _____ in., _____ ft.

Sand _____

Gas _____

Oil _____

Total Depth _____

PRODUCTION

1st 24 hrs. Nat. _____

1st 24 hrs. after shot _____

Gas _____ Cu. Ft.

Dry Hole _____

Abandoned _____

Date

SEP 17 1941 19S. J. LEWIS Scout

Ellsworth

KANSAS

Map No. K-55 Sec. 33 Twp. 17 R. 10W

Well No. 4 Stumps

Braine & Goering Company

ABANDONED

Contractor

C EL SE SW

SECTION PLAT

_____ Ft. from N. Line

660 Ft. from S. Line

330 Ft. from E. Line

_____ Ft. from W. Line

BLOOMER POOL

Location _____

Rig up _____

Drilling and Remarks:

Ar 79276

No show

RECORD

Cased _____ in., _____ ft.

Sand _____

Gas _____

Oil _____

Total Depth 2300

PRODUCTION

1st 24 hrs. Nat. _____

1st 24 hrs. after shot _____

Gas _____ Cu. Ft.

Dry Hole _____

Abandoned _____

Date

OCT 1 1941 19

S. J. LEWIS Scout