


Section 33 Township 17 Range 10-~~11~~

Well No. #4 Cain stumps

Company Transwestern et al

NORTH Bloomer pool

13

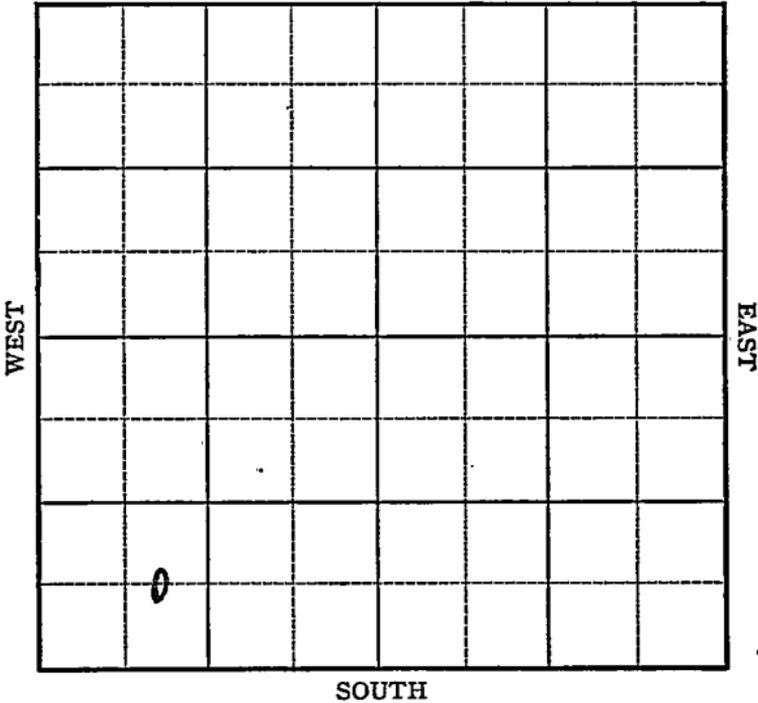

Sec. 33 Twp. 17 R. 10-W

Well No. #1 Cain Stumps #4 Farm

Transwestern et al Company

(Bloomer)


_____ Ft. from N. Line

660 Ft. from S. Line

_____ Ft. from E. Line

990 Ft. from W. Line

Elev. 1784

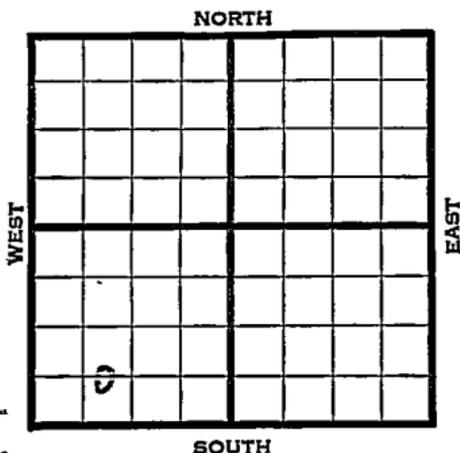

1941	REPORT
10/1	S. H.
10/16	Drl g. 2435'
10/22	Lans. 2934' Arb. 3262' T.D. 3290' No shows.
	ABANDONED

Map No. K-55 Sec. 33 Twp. 17 R. 10WWell No. 1 Cain StumpsTranswestern etal CompanyFIRST REPORT Contractor

C EL SW SW

 Ft. from N. Line660 Ft. from S. Line Ft. from E. Line990 Ft. from W. Line

SECTION PLAT

o			

BLOOMER POOL

Location Rig up

Drilling and Remarks:

S. H.

RECORD

Cased in., ft.Sand Gas Oil Total Depth

..PRODUCTION

1st 24 hrs. Nat. 1st 24 hrs. after shot Gas Cu. Ft.Dry Hole Abandoned

Date

OCT 1 1941 19

S. J. LEWIS

Scout

Sam - We show 3 wells - No's 1-2 & 3
in the $W\frac{1}{2}$ SW $\frac{1}{4}$ of Sec 33 owned by
Transwestern. Couldn't this be
#4 rather than #1.

Misc. Small Maps	<i>[Signature]</i>
Cards	<i>[Signature]</i>
Tracing	<i>[Signature]</i>
France Map	<i>[Signature]</i>
Scarborough Map	<i>[Signature]</i>
Moody Map	<i>[Signature]</i>
Geological Dept.
Moody Plat Book

Ellsworth **KANSAS**Map No. 11-51 Sec. 33 Twp. 17 R. 10WWell No. 4 Cain StumpsTranswestern et al CompanyCORRECTION Contractor

C E L S W S W

 Ft. from N. Line660 Ft. from S. Line Ft. from E. Line990 Ft. from W. Line

BLOOMER POOL

SECTION PLAT

Location Rig up

Drilling and Remarks:

Changed from
#1 Cain Stumps

RECORD

Cased in., ft.Sand Gas Oil Total Depth

PRODUCTION

1st 24 hrs. Nat. 1st 24 hrs. after shot Gas Cu. Ft.Dry Hole Abandoned

Date

OCT 15 1941 19S. J. LEWIS Scout

Map No. 11-55 Sec. 33 Twp. 17 R. 10W

Well No. 4 Cain Stumps

Transwestern etal Company

ABANDONED Contractor

SECTION PLAT

C EL SW SW

 Ft. from N. Line

660 Ft. from S. Line

 Ft. from E. Line

990 Ft. from W. Line

BLOOMER POOL

Location

Rig up

Drilling and Remarks:

Wane 2934
Cr Y 3262
No show

RECORD

Cased in., ft.

Sand

Gas

Oil

Total Depth 3290

PRODUCTION

1st 24 hrs. Nat.

1st 24 hrs. after shot

Gas Cu. Ft.

Dry Hole

Abandoned

Date

OCT 22 1941 19

S. I. LEWIS Scout