




Map No. \_\_\_\_\_ Sec. 18 Twp. 29 R. 4  
 Well No. 3 \_\_\_\_\_ Farm \_\_\_\_\_  
 \_\_\_\_\_ Company

NORTH

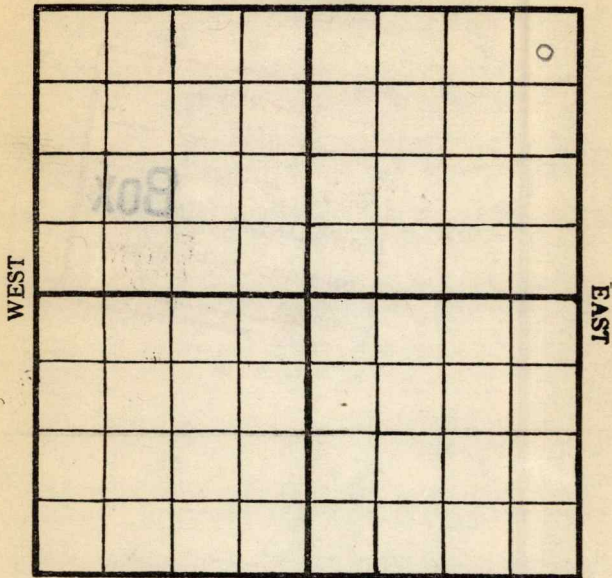

SOUTH

Location \_\_\_\_\_

Rig Up

Drilling and remarks

*offset Ruthersud*

**FIRST REPORT**

**RECORD**

Cased \_\_\_\_\_ in. \_\_\_\_\_ Ft.

Sand \_\_\_\_\_

Gas \_\_\_\_\_

Oil \_\_\_\_\_

Total Depth \_\_\_\_\_

**PRODUCTION**

1st 24 hrs. Nat. \_\_\_\_\_

1st 24 hrs. after shot \_\_\_\_\_

Gas \_\_\_\_\_ Cu. Ft.

Dry Hole \_\_\_\_\_

Abandoned \_\_\_\_\_

Date

10/17, 1917 *Carney* \_\_\_\_\_ Scout


Map No. \_\_\_\_\_ Sec. 18 Twp. 29 R. 4

Well No. 3 Snowberry Farm  
Oliver Company

NORTH

WEST

EAST

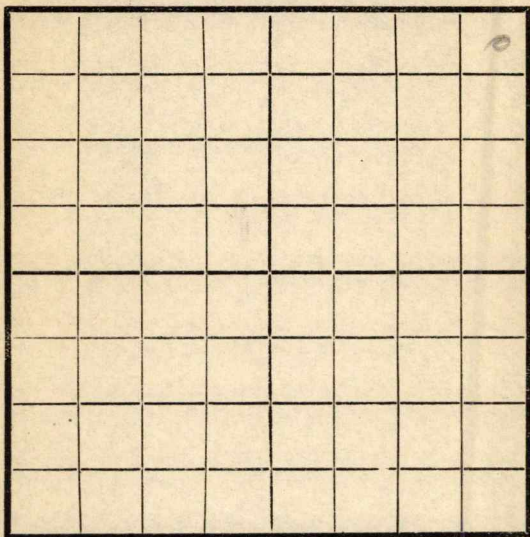

SOUTH

Location \_\_\_\_\_

Rig Up \_\_\_\_\_

Drilling and remarks  
300

**RECORD**

Cased \_\_\_\_\_ in. \_\_\_\_\_ Ft.

Sand \_\_\_\_\_

Gas \_\_\_\_\_

Oil \_\_\_\_\_

Total Depth \_\_\_\_\_

**PRODUCTION**

1st 24 hrs. Nat. \_\_\_\_\_

1st 24 hrs. after shot \_\_\_\_\_

Gas \_\_\_\_\_ Cu. Ft.

Dry Hole \_\_\_\_\_

Abandoned \_\_\_\_\_


Date

10/24/1917 Carney Scout

Map No. \_\_\_\_\_ Sec. 18 Twp. 29 R. 4

Well No. 3 Knowlsey Farm \_\_\_\_\_  
Ohio Company \_\_\_\_\_

NORTH

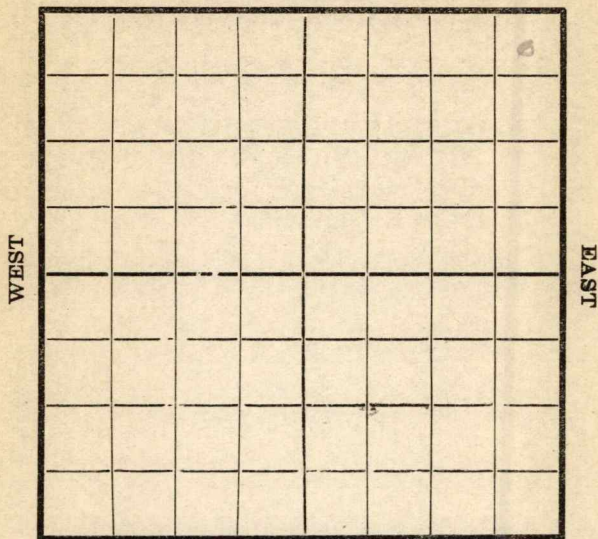

SOUTH

**RECORD**

Location \_\_\_\_\_

Cased \_\_\_\_\_ in. \_\_\_\_\_ Ft.

Rig Up \_\_\_\_\_

Sand \_\_\_\_\_

Drilling and remarks

Gas \_\_\_\_\_

Oil \_\_\_\_\_

Total Depth \_\_\_\_\_

760

**PRODUCTION**

1st 24 hrs. Nat. \_\_\_\_\_

1st 24 hrs. after shot \_\_\_\_\_

Gas \_\_\_\_\_ Cu. Ft.

Dry Hole \_\_\_\_\_

Abandoned \_\_\_\_\_

Date

10/31, 1917 Carney Scout


Map No. \_\_\_\_\_ Sec. 18 Twp. 29 R. 4

Well No. 3 Howland Farm \_\_\_\_\_  
Ohio Company \_\_\_\_\_

NORTH

WEST

EAST

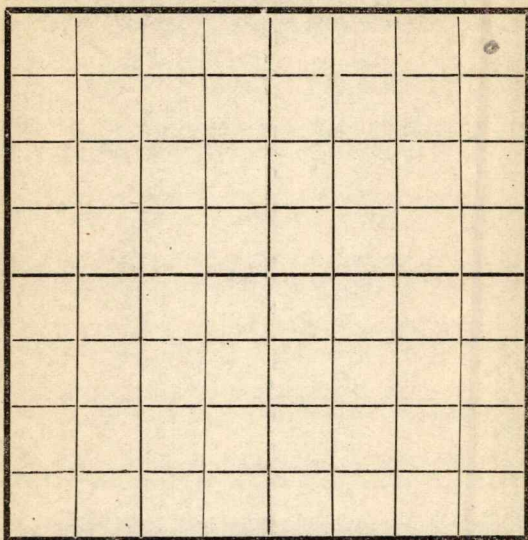

SOUTH

RECORD

Location \_\_\_\_\_  
Rig Up \_\_\_\_\_  
Drilling and remarks

Cased \_\_\_\_\_ in. \_\_\_\_\_ Ft.  
Sand \_\_\_\_\_  
Gas \_\_\_\_\_  
Oil \_\_\_\_\_  
Total Depth \_\_\_\_\_

1000

PRODUCTION

1st 24 hrs. Nat. \_\_\_\_\_  
1st 24 hrs. after shot \_\_\_\_\_  
Gas \_\_\_\_\_ Cu. Ft.  
Dry Hole \_\_\_\_\_  
Abandoned \_\_\_\_\_

Date

11-7, 1912 Cordiff Scout


Map No. \_\_\_\_\_ Sec. 18 Twp. 29 R. 4

Well No. 3 Knowlensberg Farm \_\_\_\_\_  
Oliver Company

NORTH

WEST

EAST

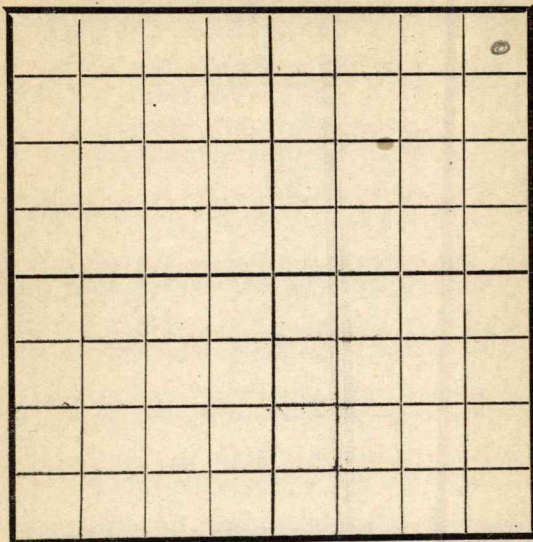

SOUTH

RECORD

Location \_\_\_\_\_  
Rig Up \_\_\_\_\_  
Drilling and remarks

Cased \_\_\_\_\_ in. \_\_\_\_\_ Ft.  
Sand \_\_\_\_\_  
Gas \_\_\_\_\_  
Oil \_\_\_\_\_  
Total Depth \_\_\_\_\_

1335

PRODUCTION

1st 24 hrs. Nat. \_\_\_\_\_  
1st 24 hrs. after shot \_\_\_\_\_  
Gas \_\_\_\_\_ Cu. Ft.  
Dry Hole \_\_\_\_\_  
Abandoned \_\_\_\_\_

Date

11-14, 1917 Conroy Scout


Map No. \_\_\_\_\_ Sec. 18 Twp. 29 R. 4

Well No. 3 Knowlberg Farm \_\_\_\_\_  
Ohio Company \_\_\_\_\_

NORTH

WEST

EAST

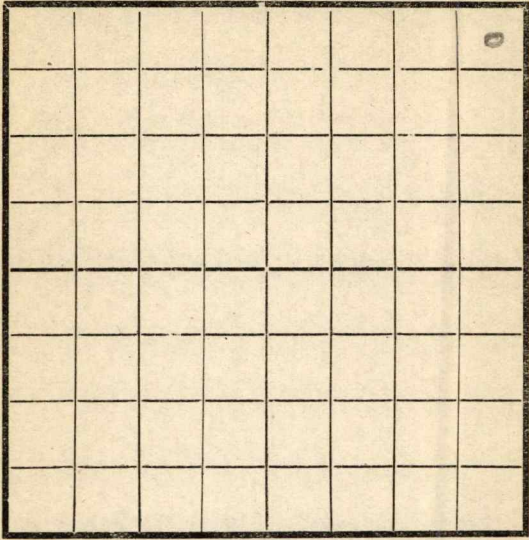

SOUTH

Location \_\_\_\_\_  
 Rig Up \_\_\_\_\_  
 Drilling and remarks

1610

**RECORD**

Cased \_\_\_\_\_ in. \_\_\_\_\_ Ft.  
 Sand \_\_\_\_\_  
 Gas \_\_\_\_\_  
 Oil \_\_\_\_\_  
 Total Depth \_\_\_\_\_

**PRODUCTION**

1st 24 hrs. Nat. \_\_\_\_\_  
 1st 24 hrs. after shot \_\_\_\_\_  
 Gas \_\_\_\_\_ Cu. Ft.  
 Dry Hole \_\_\_\_\_  
 Abandoned \_\_\_\_\_


Date

11/21, 1917 Conroy Scout

Map No. \_\_\_\_\_ Sec. 18 Twp. 29 R. 4

Well No. 3 Knowlman Farm \_\_\_\_\_  
Ohio Company \_\_\_\_\_

NORTH

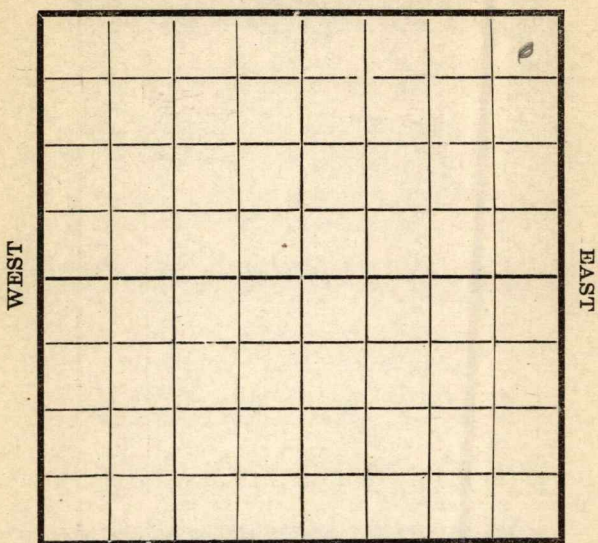

SOUTH

Location \_\_\_\_\_  
 Rig Up \_\_\_\_\_  
 Drilling and remarks

1750'

**RECORD**

Cased \_\_\_\_\_ in. \_\_\_\_\_ Ft.  
 Sand \_\_\_\_\_  
 Gas \_\_\_\_\_  
 Oil \_\_\_\_\_  
 Total Depth \_\_\_\_\_

**PRODUCTION**


1st 24 hrs. Nat. \_\_\_\_\_  
 1st 24 hrs. after shot \_\_\_\_\_  
 Gas \_\_\_\_\_ Cu. Ft.  
 Dry Hole \_\_\_\_\_  
 Abandoned \_\_\_\_\_

Date

11/28, 1917 Carly Scout

Map No. K11 Sec. 18 Twp. 29 R. 4  
 Well No. 3 Knowlton Farm  
Ohio Company

NORTH

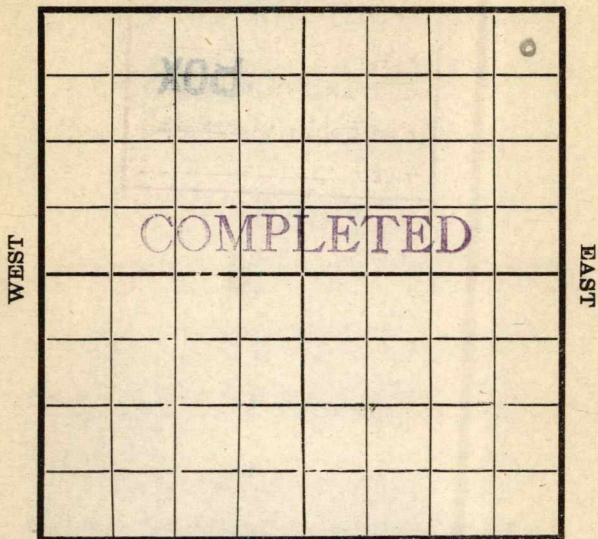

SOUTH

Location -----	<b>RECORD</b>
Rig Up -----	Cased _____ in. _____ Ft.
Drilling and remarks	Sand <u>1834 - 1841</u>
<p><u>Est at</u> <u>50 Bbls</u></p>	Gas -----
	Oil -----
	Total Depth -----
	<b>PRODUCTION</b>
	1st 24 hrs. Nat. -----
	1st 24 hrs. after shot -----
	Gas ----- Cu. Ft.
	Dry Hole -----
	Abandoned -----

Date 10/5, 1917 Conley Scout