


Section 1 Township 17 Range 11W

Well No. #1 Murray

Company R. L. Williams

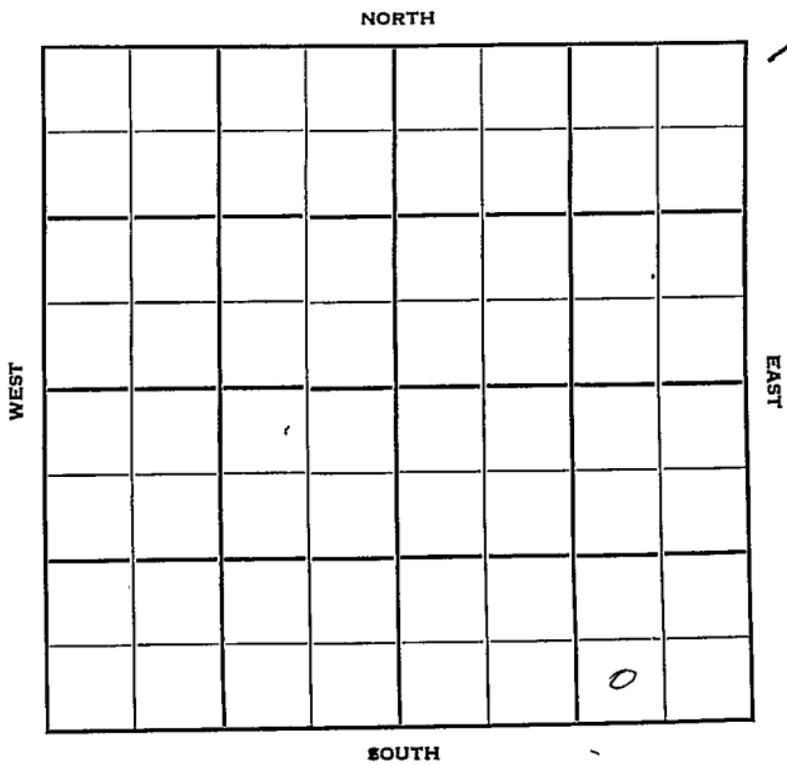

Sec. 1 Twp. 17 R. 11W ✓

Well No. #1 Murray Farm

R. L. Williams Company

Harms & Knight Contractor

Kraft-Prusa Pool


Ft. from N. Line

330' Ft. from S. Line

990' Ft. from E. Line

Ft. from W. Line

SW SE SE

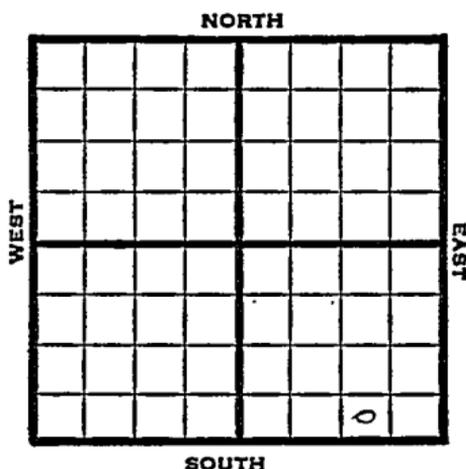

1950 Elev. 1939 REPORT

3/29 8" @ 302'
Anhy 698-750
Drlg. 2105'

5/10 TD 3402
8" @ 302
Lans 3071
Anb 3388
5" @ 3395
Set plug @ 3275
perf 44/3225-34
used 500 gals acid
pref 16/3230-34 used 5500 gals acid
P 516 BOPD
Completed

COMPLETED

Map No. _____ Sec. 1 Twp. 17 R. 11W

Well No. 1 Murray

R. L. Williams Company

Harms & Knight Contractor

SW SE SE


El. 1939
SECTION PLAT

_____ Ft. from N. Line

330 Ft. from S. Line

990 Ft. from E. Line

_____ Ft. from W. Line

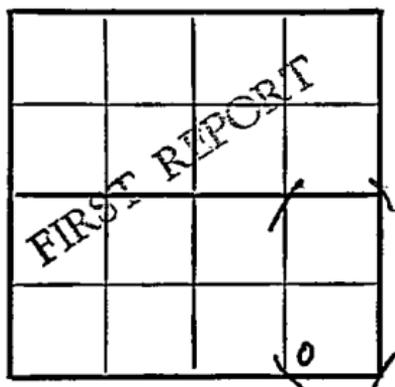

Barton County

Location _____

Rig up _____

Drilling and Remarks:

8" @ 302

Anhy 698-750

drlg. 2105

RECORD

Cased _____ in., _____ ft.

Sand _____

Gas _____

Oil _____

Total Depth _____

PRODUCTION

1st 24 hrs. Nat. _____

1st 24 hrs. after shot _____

Gas _____ Cu. Ft.

Dry Hole _____

Abandoned _____

Date

MAR 29 1950 19 _____

J. E. TYRA

Scout

perf 44/3225-34 used
500 gals acid.

perf 16/3230-34 used
5500 gals acid

P. 516 BOPD



W J H S
L I C E N S E

MAY 19 1950

3388
3389
- Scout Cards 2 W
- Land Small Map 3
- Land Wall Map 3
- Tracings
- France Map
- Pierce Map
- Misc.