

STATE OF KANSAS
BUTLER COUNTY


22935

Soil	10
Lime	40
Slate	90
Lime wtr 105	115
Shale	132
Lime	170
Slate	195
Shale	230
Lime	275
Slate	300
Lime	345
Shale	360
Slate	375
Lime	405
Slate	425
Lime	465
Shale	480
Lime	545
Slate	570
Shale wtr	575
Lime	615
Slate	650
Lime	685
Shale	700
Slate	725
Lime	760
Slate	795
Lime	815
Slate	835
Lime	880
Shale	925
Lime	960
Slate	1000
Lime	1050
Slate	1065
Lime	1095
Shale	1120
Lime	1160
Slate wtr 1200	1185
Lime	1225
Slate	1240
Lime	1275
Shale	1295
Lime	1345
Slate	1356
Lime	1400
Slate	1415
Lime	1460
Shale	1485
Lime	1520
Slate	1545
Shale	1560
Slate	1595
Lime	1610
Slate	1625
Lime	1650
Shale	1670
Slate	1697
Lime	1745
Slate	1760
Lime	1795
Shale	1815
Lime	1860
Slate	1876
Lime	1905
Shale	1915
Sand	1928 TD

Farm Knollenberg No. 9
Ohio Mid Kansas Company

Elev. T. D.

Log No. 18-29-4E

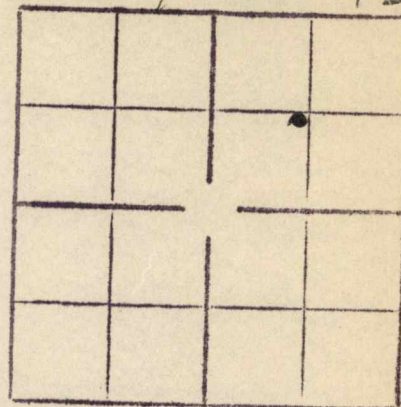

Comm 8-20-20

Comp 12-10-20

Casing

15	132
12	575
10	1356
8	1450
6	1697
5	1876

1915
1250
660