


Map No. _____ Sec. 18 Twp. 29 R. 4
Well No. 1 Stanley Farm
Stanley, Hyde et al. Company

NORTH

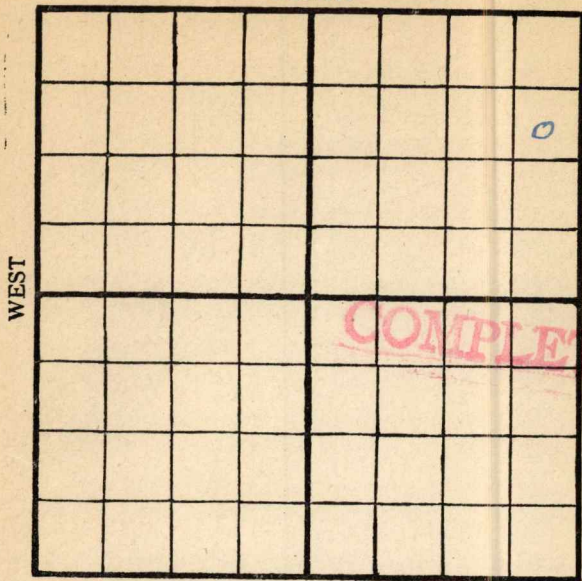

SOUTH

Location _____

Rig Up _____

Drilling Remarks:

Drilling Remarks:

RECORD

PRODUCTION

Cased _____ in. _____ ft.
Sand _____
Gas _____
Oil _____
Total Depth _____


1st 24 hrs. Nat. _____
1st 24 hrs. after shot _____
Gas _____ cu. ft.
Dry Hole _____
Abandoned _____

Map No. 1511 Sec. 18 Twp. 29 R. 4
 Well No. Stanley
Stanley - Hydr Company _____ Contractor _____

NORTH

WEST

EAST

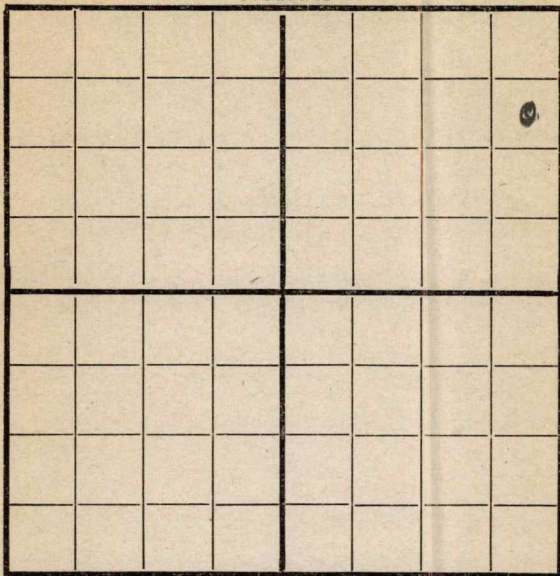

SOUTH

990 N 330 E

Location _____

Rig up ✓

Drilling and Remarks:

RECORD

Cased _____ in., _____ ft.

Sand _____

Gas _____

Oil _____

Total Depth _____

PRODUCTION

1st 24 hrs. Nat. _____

1st 24 hrs. after shot _____

Gas _____ Cu. Ft.

Dry Hole _____

Abandoned _____

Date

8/28 8 Canby
 _____ 191 _____

Scout

Map No. K11 Sec. 18 Twp. 29 R. 4Well No. 1 StanleyStanley & Hytars Company

Contractor

NORTH

WEST

EAST

FIRST REPORT

SOUTH

RECORD

Location ✓

Cased _____ in., _____ ft.

Rig up ✓

Sand _____

Drilling and Remarks:

Gas _____

Oil _____

Total Depth _____

PRODUCTION

1st 24 hrs. Nat. _____

1st 24 hrs. after shot _____

Gas _____ Cu. Ft.

Dry Hole _____

Abandoned _____

Date

8/24 1918 C. Conley Scout

Map No. 1511 Sec. 18 Twp. 29 R. 4

Well No. 1 Stanley

Stanley - N.Y.T. Company

Campogney Tools Contractor

Douglas & Sons NORTH

WEST								EAST

SOUTH

990 X 330 E

Location _____

Rig up _____

Drilling and Remarks:

150

RECORD

Cased _____ in., _____ ft.

Sand _____

Gas _____

Oil _____

Total Depth _____

PRODUCTION

1st 24 hrs. Nat. _____

1st 24 hrs. after shot _____

Gas _____ Cu. Ft.

Dry Hole _____

Abandoned _____

Date

9/4 191 S. Candiff Scout

Map No. K11 Sec. 18 Twp. 29 R. 4

Well No. 1 Stanley
Stanley-Hydrat et al Company
 Contractor

NORTH

WEST

EAST

							0

SOUTH

990 N-330 E

RECORD

Location _____

Cased _____ in., _____ ft.

Rig up _____

Sand _____

Drilling and Remarks:

Gas _____

Oil _____

Total Depth _____

350

PRODUCTION

1st 24 hrs. Nat. _____

1st 24 hrs. after shot _____

Gas _____ Cu. Ft.

Dry Hole _____

Abandoned _____


Date

9/11

191

Scout

Map No. K11 Sec. 18 Twp. 29 R. 4
Well No. 1 Stanley
Stanley-Hydel et al Company
Contractor

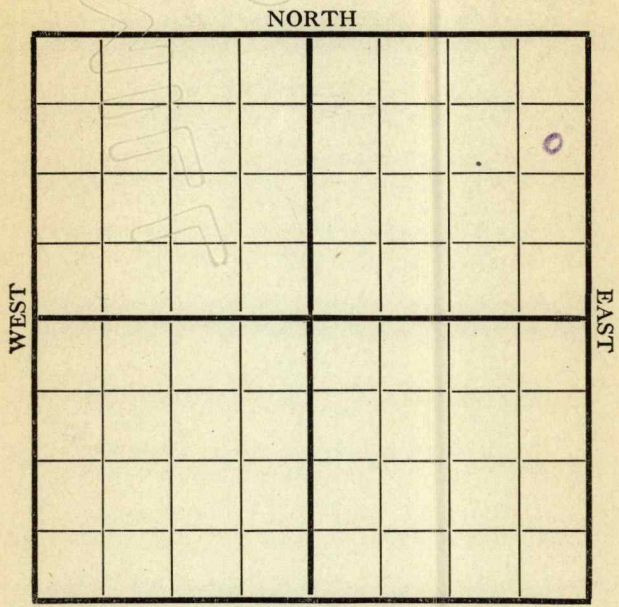

9907 330E

Location _____
Rig up _____
Drilling and Remarks:

850

RECORD

Cased _____ in., _____ ft.
Sand _____
Gas _____
Oil _____
Total Depth _____

PRODUCTION


1st 24 hrs. Nat. _____
1st 24 hrs. after shot _____
Gas _____ Cu. Ft.
Dry Hole _____
Abandoned _____

Date 9/18 1918 S. C. Camp Scout

Map No. K11 Sec. 18 Twp. 29 R. 4
 Well No. 1 Stanley
Stanley Co. Company
 Contractor

NORTH

WEST

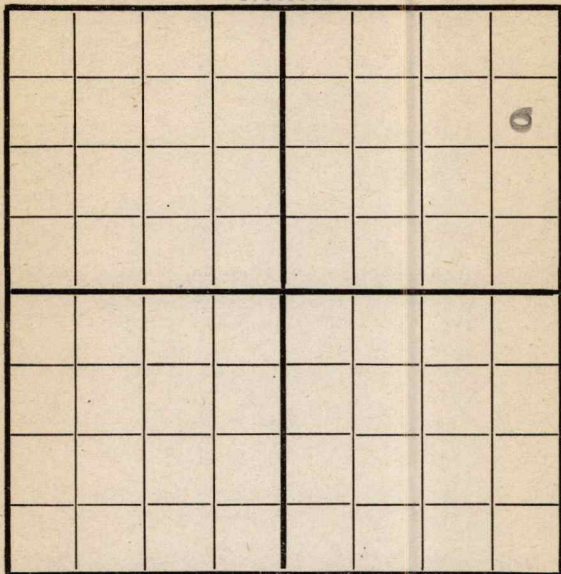

EAST

SOUTH

99018 230 E

Location _____

Rig up _____

Drilling and Remarks:

1495

RECORD

Cased _____ in., _____ ft.

Sand _____

Gas _____

Oil _____

Total Depth _____

PRODUCTION

1st 24 hrs. Nat. _____

1st 24 hrs. after shot _____

Gas _____ Cu. Ft.

Dry Hole _____

Abandoned _____

Date

9/25-8 C. C. C. C. Scout



Company

Contractor

NORTH

WEST

EAST

SOUTH

RECORD

Location _____

Cased _____ in., _____ ft.

Rig up-----

Sand_____

Drilling and Remarks:

Gas _____

Oil _____

Total Depth.....

PRODUCTION

1st 24 hrs. Nat. -----

1st 24 hrs. after shot-----

Gas.....Cu. Ft.

Dry Hole.—

Abandoned.....

Date _____

191

Scout

Map No. 1511 Sec. 18 Twp. 29 R. 4Well No. StanleyStanley Hyde Oil CompanyCompany Drilling Contractor

NORTH

WEST

COMPLETED

EAST

SOUTH

RECORD

Location _____

Cased _____ in., _____ ft.

Rig up _____

Sand 1835-1853

Drilling and Remarks:

Gas _____

Oil _____

Total Depth _____

PRODUCTION

1st 24 hrs. Nat. _____

1st 24 hrs. after shot _____

Gas _____ Cu. Ft.

Dry Hole _____

Abandoned _____

Date

10/8 1918 Stanley Scout