


Section 18 Township 29 Range 4-E

Well No. #1, Milleson

Company E. Adair

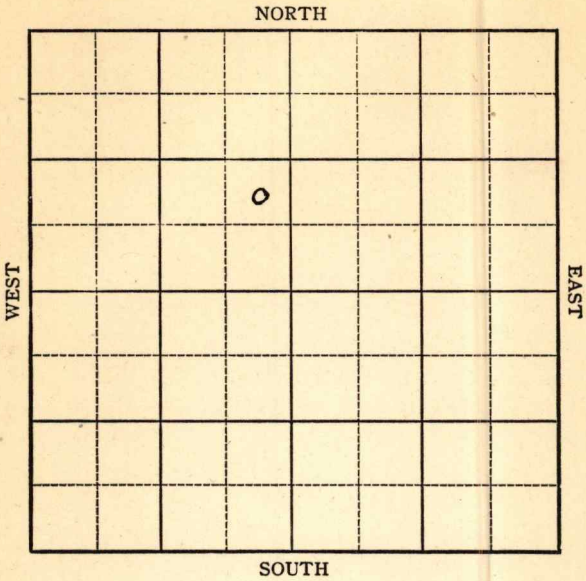

Sec. 18 Twp. 29 R. 4E

Well No. #1 Milleson Farm
E. Adair Company


Miscellaneous

_____ Ft. from N. Line

990 Ft. from S. Line

330 Ft. from E. Line

_____ Ft. from W. Line

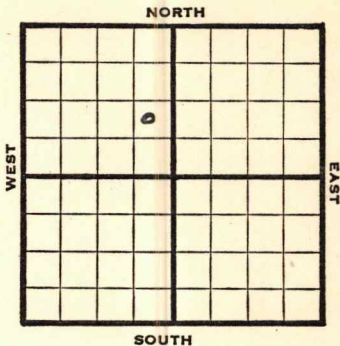

NE SE NW

1946

1252

REPORT

9/18 Location

9/24 Mach

10/1 20" @ 15'
148' Run 15"

10/8 15" @ 149
13" @ 469'
Drlg 1115'

10/15 10" @ 1340'
Drlg 1942'

10/22 **Lans 1918**
TD 1956'
6" @ 1925'
50 qts 1936-56 CO

10/30 **Lans 1918'**
6" @ 1925'
500 Acid
TD 2050'

ABANDONED

Kansas Pool Name Miscellaneous

KANSAS

Map No. Sec. 18 Twp. 29 R. 4E

Well No. 1 Milleson

E. Adair Company

FIRST REPORT Contractor

NE SE NW

SECTION PLAT

 Ft. from N. Line

990 Ft. from S. Line

330 Ft. from E. Line

 Ft. from W. Line

	o		

Butler County

Location X

Rig up

Drilling and Remarks:

All wells
Abanded

RECORD

Cased in., ft.

Sand

Gas

Oil

Total Depth

PRODUCTION

1st 24 hrs. Nat.

1st 24 hrs. after shot

Gas Cu. Ft.

Dry Hole

Abandoned

Date

SEP 1 8 1946 19

S. J. LEWIS

Scout

