



Woodson

Sec. 5 Twp. 24 R. 14E

Well No. #3 Burk Farm

R. E. French et al Company


Miscellaneous

\_\_\_\_\_ Ft. from N. Line

330' Ft. from S. Line

330' Ft. from E. Line

\_\_\_\_\_ Ft. from W. Line

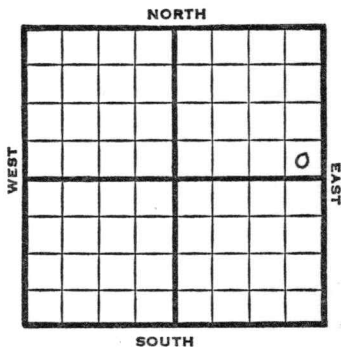

SE NE

1949	Elev. REPORT
11/30	8" @ 21'
12/7	Miss 1701-
	5" @ 1701'
	TD 1711'
12/14	Miss 1701'
	5" @ 1701'
	Pump 6 oil Pot.
	Gr. 38°
	TD 1714'
	<b>COMPLETED</b>

Map No. \_\_\_\_\_ Sec. 5 Twp. 24 R. 14E

Well No. 3 Burk

R. E. French etal. Company

Sunflower Contractor

SE NE

FIRST REPORT  
SECTION PLAT


\_\_\_\_\_ Ft. from N. Line

330 Ft. from S. Line

330 Ft. from E. Line

\_\_\_\_\_ Ft. from W. Line

Woodson County

Location \_\_\_\_\_

Rig up \_\_\_\_\_

Drilling and Remarks:

8" @ 21

RECORD

Cased \_\_\_\_\_ in., \_\_\_\_\_ ft.

Sand \_\_\_\_\_

Gas \_\_\_\_\_

Oil \_\_\_\_\_

Total Depth \_\_\_\_\_

PRODUCTION

1st 24 hrs. Nat. \_\_\_\_\_

1st 24 hrs. after shot \_\_\_\_\_

Gas \_\_\_\_\_ Cu. Ft.

Dry Hole \_\_\_\_\_

Abandoned \_\_\_\_\_

Date

NOV 30 1949 19

S. J. LEWIS

Scout

Map No. \_\_\_\_\_ Sec. 5 Twp. 24 R. 14E

Well No. 3 Burk

R. E. French et al. Company

COMPLETE Contractor

SE NE

SECTION PLAT

\_\_\_\_\_ Ft. from N. Line

330 Ft. from S. Line

330 Ft. from E. Line

\_\_\_\_\_ Ft. from W. Line


Woodson County

Location \_\_\_\_\_

Rig up \_\_\_\_\_

Drilling and Remarks:

*Miss 1701*  
*5" C 1701*  
*Pump 6 oil Pot*  
*389*

RECORD

Cased \_\_\_\_\_ in., \_\_\_\_\_ ft.

Sand \_\_\_\_\_

Gas \_\_\_\_\_

Oil \_\_\_\_\_

Total Depth 1714

PRODUCTION

1st 24 hrs. Nat. \_\_\_\_\_

1st 24 hrs. after shot \_\_\_\_\_

Gas \_\_\_\_\_ Cu. Ft.

Dry Hole \_\_\_\_\_

Abandoned \_\_\_\_\_

Date

DEC 14 1949

19

S. J. LEWIS

Scout