

Butler Co

Map No. Kansas Sec. 19 Twp. 29 R. 4


Well No. 1 Owen Farm
Hartman & Maur Company

..... Ft. from N. Line

250 Ft. from S. Line

250 Ft. from E. Line

..... Ft. from W. Line

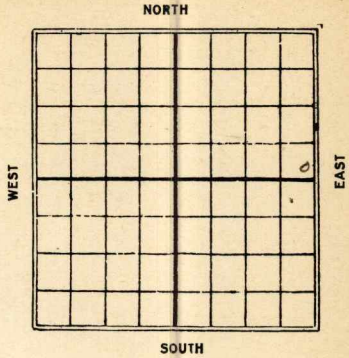

Date	REPORT
1926	
6/17	Location
6/25	same
6-30	—
7/18	—
7/15	—
7/22	timber
7/28	Rigging up
8/4	Spudding
8/11	Spudg 1500
8/18	Drlg 430
8/25	Drlg 540
8/27	" 615
9/15	" 675
9/22	" 700
9/29	" 750
10/13	same
10/27	drlg 850'
11/11	S.D. 850'
11/17	U.R. 1080
11/23	Same
12/8	S.D. 1455
12/15	Drlg 1585'

12/22 Drlg 18 75' good showing
oil.

12/30 - sandy lime 1883-1904 T.D.
1914 - shot 20 gts. 10 bbl show
will drill deeper

1927

1/6 - Drlg. 1980

1/13 - shut down 2000

1/19 - Drilling 2475

1/26 - " 2550

2/3 - " 2820

2/10 - Topline 2815 - Wilcox 3097
H.F.W. 3101 - P.B. to 1905-14
will shoot 100 gts.

2/16 - sdy lime 1883-1904
20/10 bbl show
Topline 2815
Wilcox 3097 - H.F.W.
3101 - D.O.A. 3101'

Butler Co

1011 KANSAS
Map No. _____ Sec. 19 Twp. 29 R. 4

Well No. 1 Owen

Hartman & Sheen Company

Contractor

FIRST REPORTS

_____ Ft. from N. Line

250 Ft. from S. Line

250 Ft. from E. Line

_____ Ft. from W. Line

SECTION PLAT

			0

Location ✓ _____

Rig up _____

Drilling and Remarks:

RECORD

Cased _____ in., _____ ft.

Sand _____

Gas _____

Oil _____

Total Depth _____

PRODUCTION

1st 24 hrs. Nat. _____

1st 24 hrs. after shot _____

Gas _____ Cu. Ft.

Dry Hole _____

Abandoned _____

Date

JUN 17 1926

CHAS. L. SHERWOOD
Scout

Butler

Map No. 11 KANSAS Sec. 19 Twp. 29 R. 4

Well No. 1 Owen

Hartman & Shaen Company

Contractor

COMPLETED

SECTION PLAT

----- Ft. from N. Line

250

----- Ft. from S. Line

250

----- Ft. from E. Line

----- Ft. from W. Line

			o

ABANDONED

Location -----

Rig up -----

Drilling and Remarks:

Ady line 1883-1904
20y 10 Bl show
th 2815
Wilcox 3097 Afw
3101 DQH 3101

RECORD

Cased ----- in., ----- ft.
 Sand -----
 Gas -----
 Oil ----- *3101*
 Total Depth ----- *3101*

PRODUCTION

1st 24 hrs. Nat. -----
 1st 24 hrs. after shot -----
 Gas ----- Cu. Ft.
 Dry Hole
 Abandoned

Date

FEB 16 1927

CHAS. L. SHERWOOD

192

Scout

Butler
 K11
 MAP NO. KANSAS SEC. 19 TWP. 29S R. 1E
 WELL NO. 1(a) Owen
Hortman + Skae COMPANY

CONTRACTOR

ABANDONED

SECTION PLAT

			0

_____ FT. FROM N. LINE
 _____ FT. FROM S. LINE
 _____ FT. FROM E. LINE
 _____ FT. FROM W. LINE

LOCATION _____

RIG UP _____

DRILLING AND REMARKS:

RECORD

CASED _____ IN. _____ FT.
 SAND _____
 GAS _____
 OIL _____
 TOTAL DEPTH 3101

PRODUCTION

1ST 24 HRS. NAT. _____
 1ST 24 HRS. AFTER SHOT _____
 GAS _____ CU. FT.
 DRY HOLE ✓
 ABANDONED _____

DATE

Feb 15 1927 SCOUT