


Section 5 Township 24 Range 11 E

Well No. # 7 Birk

Company R. E. French Oil Co. et al

NORTH

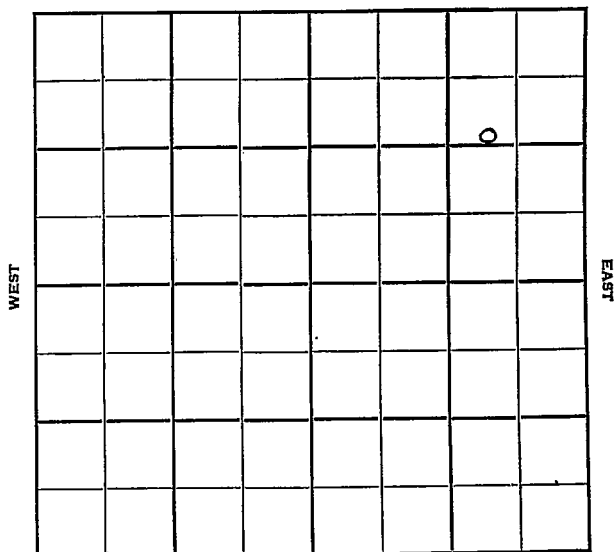

SOUTH

Woodson
24

KANSAS
14E

Sec. 5 Twp. _____ R. _____

Well No. #7 Birk Farm _____

R. E. French Oil Co. et al Company _____

Contractor _____


1200' Ft. from N. Line

_____ Ft. from S. Line

800' Ft. from E. Line

_____ Ft. from W. Line

W/2 E/2 NE

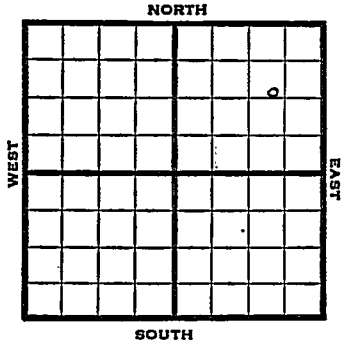

1951

Elev. - REPORT

6/27

Spud 6-10-51
8" @ 41'
Miss 1680
RTD 1687
4" @ 1687'

7/11

Spud 6-10-51 Oil well TD 1695'
8" @ 41' Miss 1680' 4" @ 1687'
TD 1695'
Comp. 2 1/2 BOPD

COMPLETED

