

KANSAS

Butler


Form 51-5M-7-40-Palace

Section 19 Township 29 Range 4-E

Well No. 2 Owen

Company Simpson Oil et al

NORTH Douglas Pool

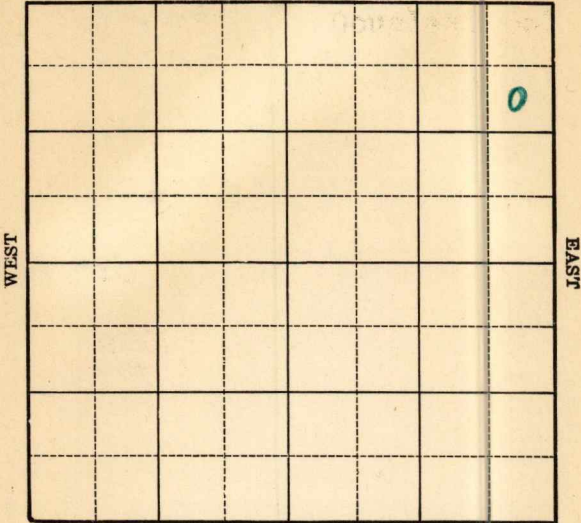

SOUTH

Map No. 11 Sec. 19 Twp. 29 R. 4E

Well No. 2 Owen

Simpson Oil etal Company

Contractor

~~FIRST REPORT~~

SECTION PLAT

SE NE NE

990 Ft. from N. Line

_____ Ft. from S. Line

330 Ft. from E. Line

_____ Ft. from W. Line

DOUGLAS POOL

Location _____

Rig up _____

Drilling and Remarks:

Machine _____

RECORD

Cased _____ in., _____ ft.

Sand _____

Gas _____

Oil _____

Total Depth _____

PRODUCTION

1st 24 hrs. Nat. _____

1st 24 hrs. after shot _____

Gas _____ Cu. Ft.

Dry Hole _____

Abandoned _____

Date

FEB 19 194119

S. J. LEWIS

Scout

Map No. 11 Sec. 19 Twp. 29 R. 4E

Well No. 2 Owen

Simpson Oil etal Company

Contractor

COMPLETED

SE NE NE

990 Ft. from N. Line

_____ Ft. from S. Line

330 Ft. from E. Line

_____ Ft. from W. Line

Douglas Pool

SECTION PLAT

			o

Location _____

Rig up _____

Drilling and Remarks:

Lans 1870

5" C 1878.

*Pump 25 oil
35 Water Pot*

36 5/8

RECORD

Cased _____ in., _____ ft.

Sand _____

Gas _____

Oil _____

Total Depth 1914

PRODUCTION

1st 24 hrs. Nat. _____

1st 24 hrs. after shot _____

Gas _____ Cu. Ft.

Dry Hole _____

Abandoned _____

Date

MAR 26 1941 19

S. J. LEWIS Scout