

KANSAS


Barton

FORM 51 5M PETROL

Section 1 Township 17 Range 11-W

Well No. #1 Smith "D"

Company Cities Service Oil

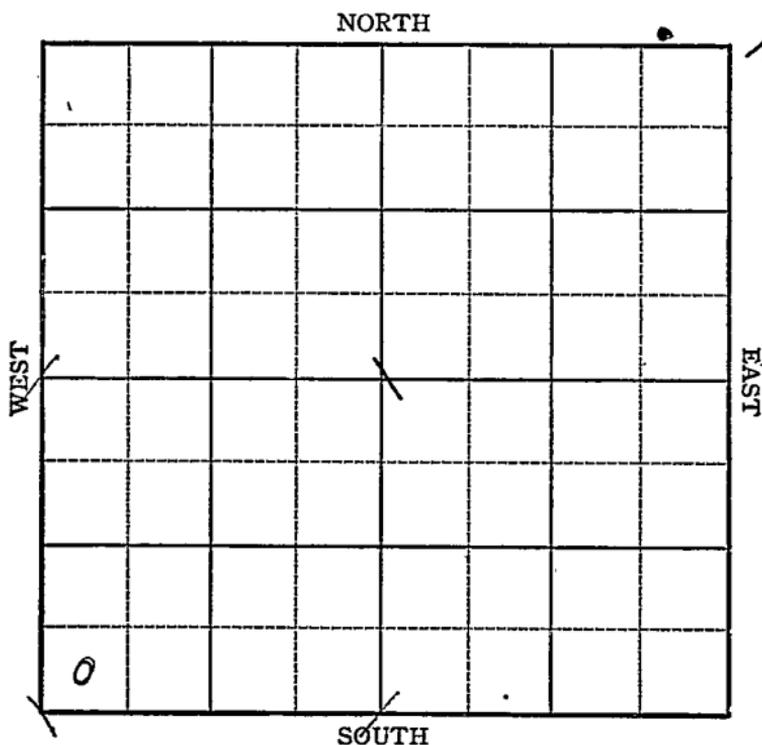

Sec. 1 Twp. 17 R. 11-W

Well No. #1 Smith "D" Farm

Cities Service Oil Company


_____ Ft. from N. Line

330 Ft. from S. Line

_____ Ft. from E. Line

330 Ft. from W. Line

Elev. 1939

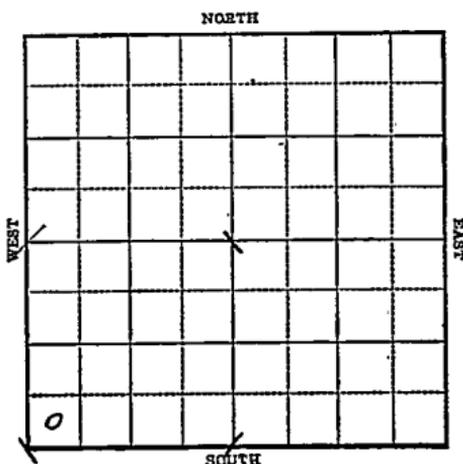

1943

R E P O R T

10/6

Cellar

10/13

Drlg. 129'

10/20

Drlg. 1882'

10/27

Drlg. 2954'

11/3

Arb 3388

T.D. 3390 S

64" @ 3389

Rust

11/10

"

11/17

TD 3393

Pump 126 oil in 24 hrs.

11/24

" "

12/1

" "

12/8

4" @ 3389

Arb 3388

Pump 148 Pot.

T.D. 3393

Gravity 42.3

COMPLETED


KANSAS

Map No. 50 Sec. 1 Twp. 17 R. 11WWell No. 1 Smith "D"Cities Service Oil Company

FIRST REPORT Contractor

SW/C

SECTION PLAT

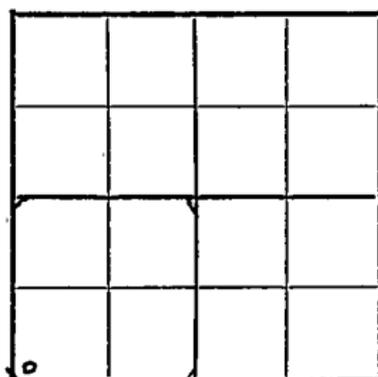 Ft. from N. Line330 Ft. from S. Line Ft. from E. Line330 Ft. from W. LineKraft Prusa PoolLocation Rig up

Drilling and Remarks:

Celler

RECORD

Cased in., ft.Sand Gas Oil Total Depth

PRODUCTION

1st 24 hrs. Nat. 1st 24 hrs. after shot Gas Cu. Ft.Dry Hole Abandoned

Date

OCT 6 1943 19S. J. LEWIS Scout

Map No. 5 Sec. 1 Twp. 17 R. 11W

Well No. 1 Smith. "D"

Cities Service Oil Company

COMPLETED Contractor

SW/C

SECTION PLAT

_____ Ft. from N. Line

330 Ft. from S. Line

_____ Ft. from E. Line

330 Ft. from W. Line

Kraft Prusa Pool

Location _____

Rig up _____

Drilling and Remarks:

Core 8.388
4" @ 3388
Pump 148 PDX

42 3/4

RECORD

Cased _____ in., _____ ft.

Sand _____

Gas _____

Oil _____

Total Depth 3393

PRODUCTION

1st 24 hrs. Nat. _____

1st 24 hrs. after shot _____

Gas _____ Cu. Ft.

Dry Hole _____

Abandoned _____

Date

DEC 8 1943

S. J. LEWIS Scout