



Sec. 1 Twp. 17 R. 11-W

Well No. #1 Ray Smith Farm

J. J. Lynn Company.

(Kraft Prusa)


990 Ft. from N. Line

\_\_\_\_\_ Ft. from S. Line

660 Ft. from E. Line

\_\_\_\_\_ Ft. from W. Line

Elev. 1922

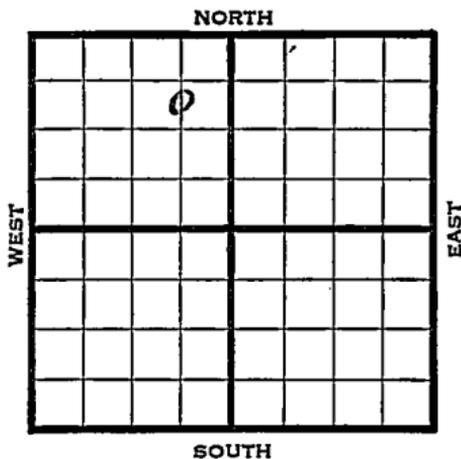

1942	REPORT
6/3	10" - 255'
	Drlg. 2193'
6/10	Lans. 3052' Cong. 3360'
	Drlg. 3370'
6/17	Arb. 3407'
	T.D. 3430'
	No shows.
	<b>ABANDONED</b>

Barton KANSAS

Map No. 51 Sec. 1 Twp. 17 R. 11WWell No. 1 Ray SmithJ. J. Lynn CompanyFIRST REPORT Contractor

C S L NE NW

## SECTION PLAT

990 Ft. from N. Line

\_\_\_\_\_ Ft. from S. Line

660 Ft. from E. Line

\_\_\_\_\_ Ft. from W. Line

	0		

KRAFT PRUSA POOL

Location \_\_\_\_\_

Rig up \_\_\_\_\_

Drilling and Remarks:

10" - 255'Drlg. 2193'

## RECORD

Cased \_\_\_\_\_ in., \_\_\_\_\_ ft.

Sand \_\_\_\_\_

Gas \_\_\_\_\_

Oil \_\_\_\_\_

Total Depth \_\_\_\_\_

## PRODUCTION

1st 24 hrs. Nat. \_\_\_\_\_

1st 24 hrs. after shot \_\_\_\_\_

Gas \_\_\_\_\_ Cu. Ft.

Dry Hole \_\_\_\_\_

Abandoned \_\_\_\_\_

Date

JUN 3 1942 19S. J. LEWIS Scout

Map No. 55 Sec. 1 Twp. 17 R. 11W

Well No. 1 Ray Smith

J. J. Lynn Company

**ABANDONED**

Contractor

C SL NE NW

SECTION PLAT

990 Ft. from N. Line

\_\_\_\_\_ Ft. from S. Line

660 Ft. from E. Line

\_\_\_\_\_ Ft. from W. Line


KRAFT PRUSA POOL

Location \_\_\_\_\_

Rig up \_\_\_\_\_

Drilling and Remarks:

*See 8.3407  
No shows*

RECORD

Cased \_\_\_\_\_ in., \_\_\_\_\_ ft.

Sand \_\_\_\_\_

Gas \_\_\_\_\_

Oil \_\_\_\_\_

Total Depth 3430

PRODUCTION

1st 24 hrs. Nat. \_\_\_\_\_

1st 24 hrs. after shot \_\_\_\_\_

Gas \_\_\_\_\_ Cu. Ft.

Dry Hole \_\_\_\_\_

Abandoned \_\_\_\_\_

Date

JUN 17 1942 19

S. J. LEWIS

Scout