

KANSAS


Barton

FORM 51, 5M BRIX

Section 1 Township 17 Range 11W

Well No. #1 Zajic

Company Threeway Drlg.

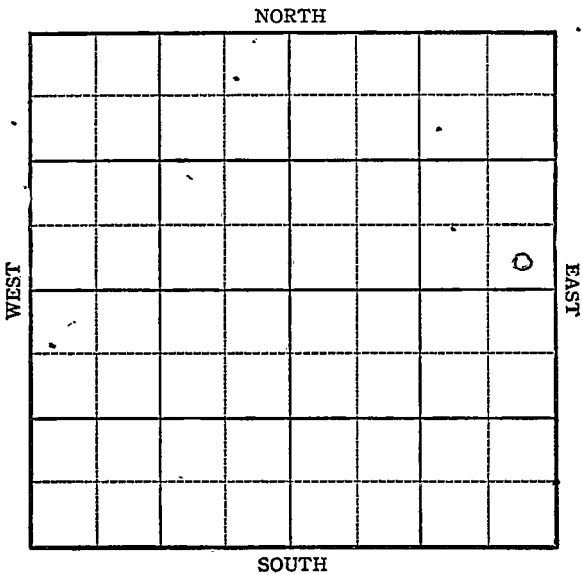

Sec. 1 Twp. 17 R. 11W

Well No. #1 Zajic Farm

Threeway Drlg. Company


Kraft-Prusa

_____ Ft. from N. Line

330 Ft. from S. Line

330 Ft. from E. Line

_____ Ft. from W. Line

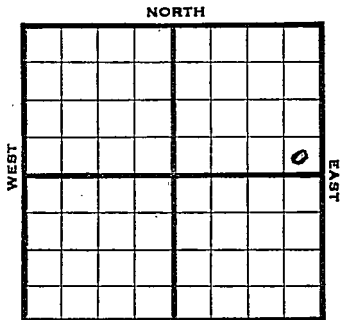

SE NE

Elm-1924

SOUTH

1945

R E P O R T

- 1/31 Location
- 2/7 8" @ 210 WOC
- 2/14 Anhy 720
Drlg 2299
- 2/21 Lans 3058
Cong 3368
Drlg 3395
- 2/28 Arb. 3384
TD 3415

ABANDONED

KANSAS

Pool Name Kraft-Pru saMap No. 55 Sec. 1 Twp. 17 R. 11WWell No. 1 ZajicThreeway Drig. CompanyFIRST REPORT Contractor

SE NE

SECTION PLAT

 Ft. from N. Line330 Ft. from S. Line330 Ft. from E. Line Ft. from W. Line

Barton

Location XRig up

Drilling and Remarks:

RECORD

Cased in., ft.Sand Gas Oil Total Depth

PRODUCTION

1st 24 hrs. Nat. 1st 24 hrs. after shot Gas Cu. Ft.Dry Hole Abandoned

Date

JAN 31 1945

19

S. J. LEWIS

Scout

Pool Name Kraft-Prusa

Map No. 55 Sec. 1 Twp. 17 R. 11W

Well No. 1 Zajic

Threeway Drlg. Company _____

ABANDONED Contractor _____

SE NE

SECTION PLAT

_____ Ft. from N. Line

330 Ft. from S. Line

330 Ft. from E. Line

_____ Ft. from W. Line

			e

Barton County

Location _____

Rig up _____

Drilling and Remarks:

Cu 83884

RECORD

Cased _____ in., _____ ft.

Sand _____

Gas _____

Oil _____

Total Depth 3415

PRODUCTION

1st 24 hrs. Nat. _____

1st 24 hrs. after shot _____

Gas _____ Cu. Ft.

Dry Hole _____

Abandoned _____

Date

FEB 28 1945

19

S. J. LEWIS Scout