


Section 1 Township 17 Range 11-W

Well No. #2 Ehly

Company R L Williams

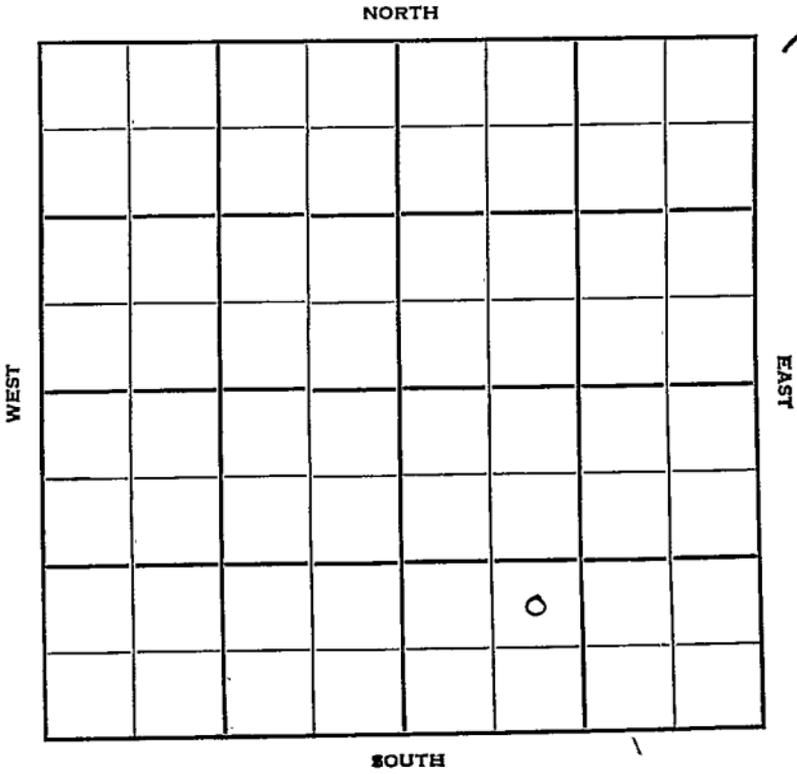

Sec. 1 Twp. 17 R. 11W

Well No. #2 Ehly Farm

R. L. Williams Company

Kraft Prusa Contractor


_____ Ft. from N. Line

990' Ft. from S. Line

_____ Ft. from E. Line

990' Ft. from W. Line

NE SW SE

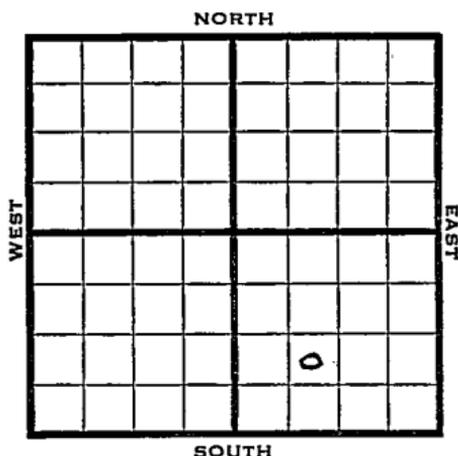

Oil Well

1950

Elev 1938

REPORT

8/9

Spud 8-3-50
8-5/8" @ 251'
Anhy 710'
Drilg. 2340'

9/13

8 5/8" @ 251
Anhy 710
Br lime 3057

Heeb 2956
Lans 3076

DST 3103-13 op 45 min rec 180' ocm
DST 3142-52 op 1/2 hr rec 30' mud
DST 3156-65 op 1 hr rec 60' gcm
Cong 3374 Arb 3408-15

5" @ 3411

18/3400-13

DD 3430

1 bwph SSO SP 3330

16/3105-09

500 A S/6 boph 3000 A

Comp 25 bopd 40% water

TD 3430

Completed

COMPLETED

County Barton State Kansas

Sec. 1 (Blk. 17) (Sur. Rge.) 11W Map No.

Operator R. L. Williams

Well No. 2 Farm Enly

Elev. Location NE SW SE

FIRST REPORT					
			0		

990 Ft. From S Line SE

990 Ft. From W Line Quarter

1st. Report AUG 9 1950

Completion

Remarks

Spudding Date 8-3-50

Drlg. Data

8 5/8" @ 251 Anhy 710 drlg. 2340

J. E. TYRA

