

Section 1 Township 17 Range 11W

Well No. 3 Smith "D"

Company Cities Service

Kraft-Prusa

NORTH

//

WEST

EAST

		0					

SOUTH

KANSAS

Barton

Sec. 1 Twp. 17 R. 11W

Well No. #3 Smith "D" Farm

Cities Service Company


990 Kraft-Pnusa  
Ft. from N. Line

Ft. from S. Line

990 Ft. from E. Line

Ft. from W. Line

SW NE SW

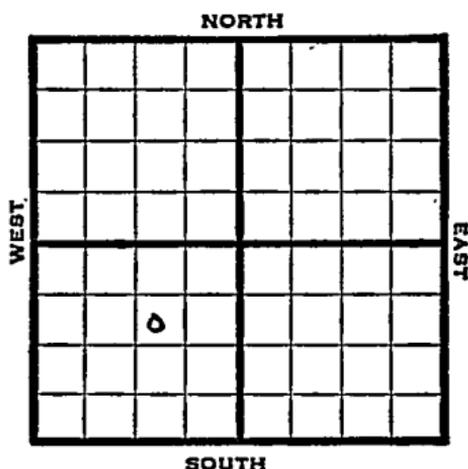

1947

Elev. 1932' REPORT

11/5	8" @ 300
11/12	Drlg. 3130'
11/19	Lansing 3070' Arbuckle 3369' TD 3371' 5" @ 3369' RUST
11/25	TD 3382' $\frac{1}{2}$ bailer oil SW PH
12/3	Acid 1700'
12/10	TD 3386' Pump 102 bbls. oil in 24 hrs.
12/17	"
12/30	"
1948	
1/7	"
1/14	"
1/21	Arb. 3369' 5" @ 3369' 1730 acid Pump 132 Pot 42.0 Gr. TD 3386' Comp.

COMPLETED

Map No. \_\_\_\_\_ Sec. 1 Twp. 17 R. 11W

Well No. 3 Smith "D"

Cities Service

Company

FIRST REPORT

Contractor

SW NE SW

SECTION PLAT

990 Ft. from N. Line


\_\_\_\_\_ Ft. from S. Line

990 Ft. from E. Line

\_\_\_\_\_ Ft. from W. Line

Barton County

Location \_\_\_\_\_

RECORD

Rig up \_\_\_\_\_

Cased \_\_\_\_\_ in., \_\_\_\_\_ ft.

Drilling and Remarks:

Sand \_\_\_\_\_

Gas \_\_\_\_\_

Oil \_\_\_\_\_

Total Depth \_\_\_\_\_

8" @ 300

PRODUCTION

1st 24 hrs. Nat. \_\_\_\_\_

1st 24 hrs. after shot \_\_\_\_\_

Gas \_\_\_\_\_ Cu. Ft.

Dry Hole \_\_\_\_\_

Abandoned \_\_\_\_\_

Date

NOV 5 1947

S. J. LEWIS

Scout

