

Barton

Sec. 1 Twp. 17 R. 11W

Well No. #5 Smith "D" Farm _____

Cities Service

Company


Kraft-Prusa Pool

_____ Ft. from N. Line

330' Ft. from S. Line

990' Ft. from E. Line

_____ Ft. from W. Line
SW SE SW

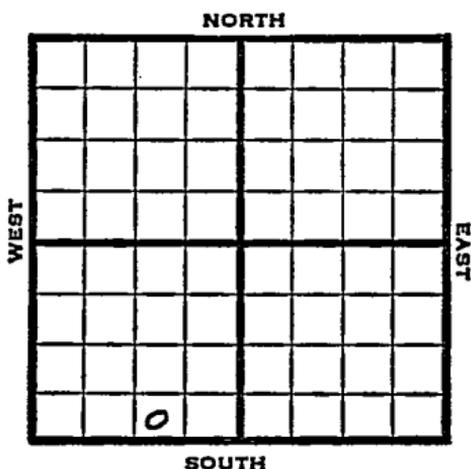

1950

Elev. 1949' REPORT

1/11
3/15

Location
TD 3405'
10"@ 331'
7"@ 3394'
Lans 3089'
Cong 3385'
Arb. 3390'
235 BOPD
Comp

COMPLETED

Kansas

Kraft-Prusa Pool

Map No. _____ Sec. 1 Twp. 17 R. 11WWell No. 5 Smith "D"

_____ Cities Service _____ Company

_____ Contractor

SW SE SW

E 1/4 1949
SECTION PLAT

_____ Ft. from N. Line

330 Ft. from S. Line990 Ft. from E. Line

_____ Ft. from W. Line

FIRST REPORT			
	0		

Barton County

Location _____

Rig up _____

Drilling and Remarks:

RECORD

Cased _____ in., _____ ft.

Sand _____

Gas _____

Oil _____

Total Depth _____

PRODUCTION

1st 24 hrs. Nat. _____

1st 24 hrs. after shot _____

Gas _____ Cu. Ft.

Dry Hole _____

Abandoned _____

Date

JAN 11 1950

19

J. E. TYRA Scout

Kansas

Map No. _____ Sec. 1 Twp. 17 R. 11WWell No. 5 Smith "D"

_____ Cities Service _____ Company

_____ Contractor


SW SE SW

E.I. 1949
SECTION FLAT

_____ Ft. from N. Line

330 Ft. from S. Line990 Ft. from E. Line

_____ Ft. from W. Line

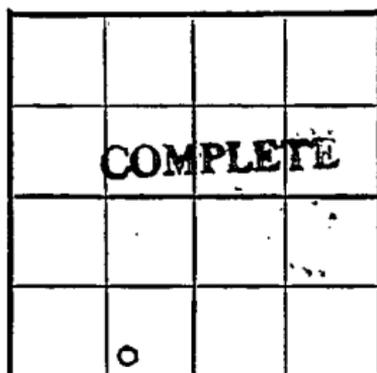

Barton County

Location _____

Rig up _____

Drilling and Remarks:

10" @ 331
 7" @ 3394
 Lens 3089
 Cong 3385
 and 3390
 235 BOPD

RECORD

Cased _____ in., _____ ft.

Sand _____

Gas _____

Oil _____

Total Depth 3405

PRODUCTION

1st 24 hrs. Nat. _____

1st 24 hrs. after shot _____

Gas _____ Cu. Ft.

Dry Hole _____

Abandoned _____

Date

MAR 15 1950 19

J. E. TYRA Scout