


Section 1 Township 17 Range 11-W

Well No. #6 Smith (D)

Company G. S. O.

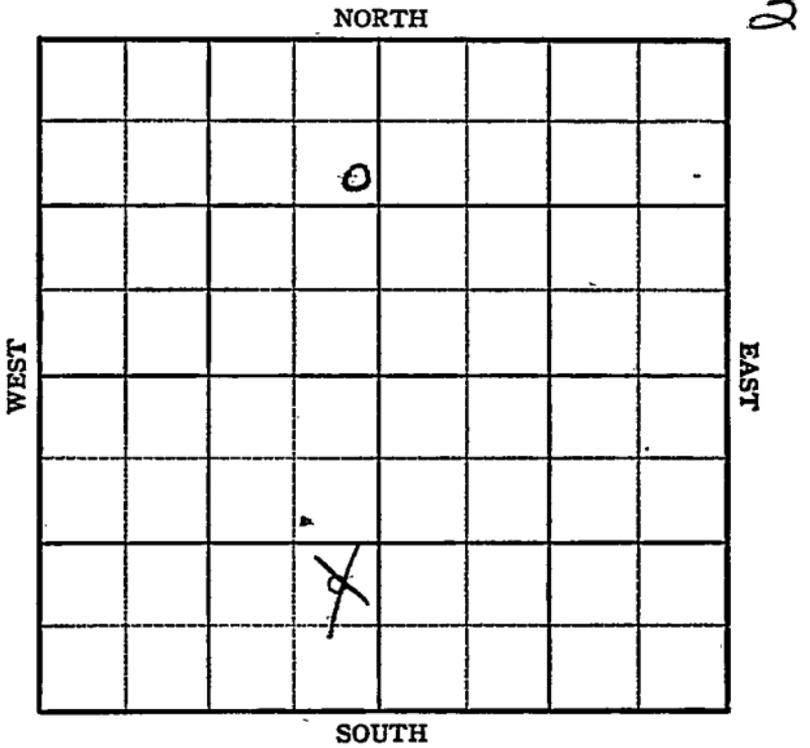

Barton

KANSAS

Sec. 1 Twp. 17 R. 11W

Well No. #6 Smith (D) Farm

C.S.O. Company


Contractor

990' Ft. from N. Line

~~990'~~ Ft. from S. Line

330' Ft. from E. Line

\_\_\_\_\_ Ft. from W. Line

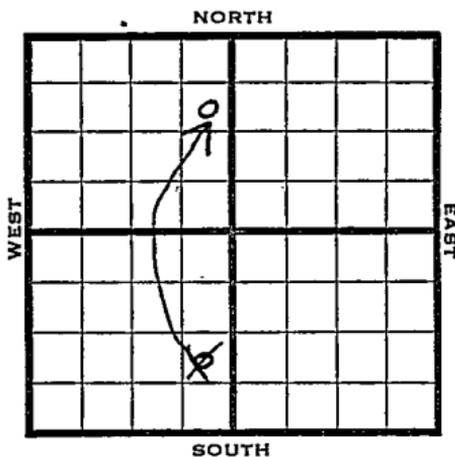

~~NE SE SW~~  
SE NE NW

1950

Elev 1944' REPORT

5/10

Location

7/19

8" @ 322

Br line 3067

Lans 3080

DST 3174-82, rec mud

DST 3252-70, rec 30' ocm

Arb 3392

5" @ 3393

100 acid

10 qt 3397-3405

TD 3416

Comp 30 bopd

Completed

**COMPLETED**

Kansas

Map No. \_\_\_\_\_ Sec. 1 Twp. 17 R. 11WWell No. 6 Smith (D)

C. S. O. \_\_\_\_\_ Company

Contractor \_\_\_\_\_

NE SE SW

## SECTION PLAT

\_\_\_\_\_ Ft. from N. Line

990 Ft. from S. Line330 Ft. from E. Line

\_\_\_\_\_ Ft. from W. Line



Part on \_\_\_\_\_

Location X

Rig up \_\_\_\_\_

Drilling and Remarks:

## RECORD

Cased \_\_\_\_\_ in., \_\_\_\_\_ ft.

Sand \_\_\_\_\_

Gas \_\_\_\_\_

Oil \_\_\_\_\_

Total Depth \_\_\_\_\_

## PRODUCTION

1st 24 hrs. Nat. \_\_\_\_\_

1st 24 hrs. after shot \_\_\_\_\_

Gas \_\_\_\_\_ Cu. Ft.

Dry Hole \_\_\_\_\_

Abandoned \_\_\_\_\_

Date

MAY 10 1950

19

J. E. TYRA Scout

Map No. \_\_\_\_\_ Sec. 1 Twp. 17 R. 11W

Well No. 6 Smith "D"

Cities Service Company

**CORRECTION**

Contractor

SE NE NW

*E. 1944*

**SECTION PLAT**

990 Ft. from N. Line

\_\_\_\_\_ Ft. from S. Line

330 Ft. from E. Line

\_\_\_\_\_ Ft. from W. Line

	o		

Barton County

Location \_\_\_\_\_

Rig up \_\_\_\_\_

Drilling and Remarks:

Reported

NE SE SW

**RECORD**

Cased \_\_\_\_\_ in., \_\_\_\_\_ ft.

Sand \_\_\_\_\_

Gas \_\_\_\_\_

Oil \_\_\_\_\_

Total Depth \_\_\_\_\_

**PRODUCTION**

1st 24 hrs. Nat. \_\_\_\_\_

1st 24 hrs. after shot \_\_\_\_\_

Gas \_\_\_\_\_ Cu. Ft.

Dry Hole \_\_\_\_\_

Abandoned \_\_\_\_\_

Date

\*

MAY 31 1950 19

J. E. TYRA

Scout

Kansas

Map No. \_\_\_\_\_ Sec. 1 Twp. 17 R. 11WWell No. 6 Smith "D"Cities Service

Company

Contractor


SE NE NW

E1. 1944  
SECTION PLAT990 Ft. from N. Line

\_\_\_\_\_ Ft. from S. Line

330 Ft. from E. Line

\_\_\_\_\_ Ft. from W. Line

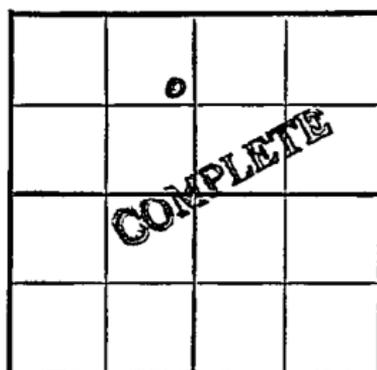Barton County

Location \_\_\_\_\_

Rig up \_\_\_\_\_

Drilling and Remarks:

8" @ 322

Br. lime 3067

Lans. 3080

DST 3174-82

Rec. mud

DST 3252-70

Rec. 30' ocm

## RECORD

Cased \_\_\_\_\_ in., \_\_\_\_\_ ft.

Sand \_\_\_\_\_

Gas \_\_\_\_\_

Oil \_\_\_\_\_

Total Depth 3416

## PRODUCTION

1st 24 hrs. Nat. \_\_\_\_\_

1st 24 hrs. after shot \_\_\_\_\_

Gas \_\_\_\_\_ Cu. Ft.

Dry Hole \_\_\_\_\_

Abandoned \_\_\_\_\_

Date

JUL 19 1950

J. E. TYRA Scout

Arb. 3392

5" @ 3393

500 acid

10 qt. 3397-3405

TD 3416


Comp. 30 pdpd

1950

Misc.
Pierce Map
France Map
Tracings
Land Wall Map
Land Small Map
Scout Cards

7-5

AUG

 

300

100