


Butler

Map No. KANSAS Sec. 19 ~~20~~ Twp 29 R. 4 ~~8~~

Well No. 1 McLaughlin Farm
Bradley et al Company

330' Ft. from N. Line
 Ft. from S. Line
330 Ft. from E. Line
~~330~~ Ft. from W. Line

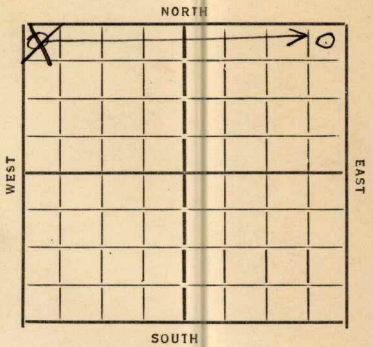

Date 1933

REPORT

12/20 Loc
12/27 —
1/4 Wreg 220
1/11 10" at 600
1/17 Wreg 1150
1/24 —
1/31 TD 1909 Dr a

ABANDONED

Map No. 11 Sec. 19 Twp. 29 R. 4 E

Well No. J. McLaughlin

Bradley et al Company

Contractor

CORRECTION

SECTION PLAT

0			0

330 Ft. from N. Line

..... Ft. from S. Line

330 Ft. from E. Line

..... Ft. from W. Line

see completion

Location..... **CORRECTION**

Rig up.....

Drilling and Remarks:

*formerly reported
ms 20-294 E*

RECORD

Cased..... in., ft.

Sand.....

Gas.....

Oil.....

Total Depth.....

PRODUCTION

1st 24 hrs. Nat.....

1st 24 hrs. after shot.....

Gas..... Cu. Ft.

Dry Hole.....

Abandoned.....

CORRECTION

Date

1-31-34 192 P. Manschreck Scout

Map No. *11* Sec. *20* Twp. *29* R. *4E*

Well No. *1-McLaughlin*

Bradley et al Company

Contractor

FIRST REPORTS

SECTION PLAT

330 Ft. from N. Line

..... Ft. from S. Line

..... Ft. from E. Line

330 Ft. from W. Line

<i>0</i>			

Location *✓*

Rig up

Drilling and Remarks:

RECORD

Cased..... in., ft.

Sand.....

Gas.....

Oil.....

Total Depth.....

PRODUCTION

1st 24 hrs. Nat.....

1st 24 hrs. after shot.....

Gas..... Cu. Ft.

Dry Hole.....

Abandoned.....

Date

12-20-33 192 *O. Manschreck* Scout

Map No. Sec. 19 Twp. 29 R. 4 E

Well No. 1-7^m c Laughlin

Bradley et al Company

..... Contractor

ABANDONED

SECTION PLAT

330 Ft. from N. Line

..... Ft. from S. Line

330 Ft. from E. Line

..... Ft. from W. Line



See correction ticket

Location.....

Rig up.....

Drilling and Remarks:

N + A

RECORD

Cased..... in., ft.

Sand.....

Gas.....

Oil.....

Total Depth 1909

PRODUCTION

1st 24 hrs. Nat.....

1st 24 hrs. after shot.....

Gas..... Cu. Ft.

Dry Hole.....

Abandoned.....

Date

1-31-34 192. O. Manned Scout