


State _____ County Woodson

Sec. 5 Twp. 24 N-S; Rge. 14 E-W

Well No. 8 Stevenson Farm _____

OKLA PER Company _____

NORTH

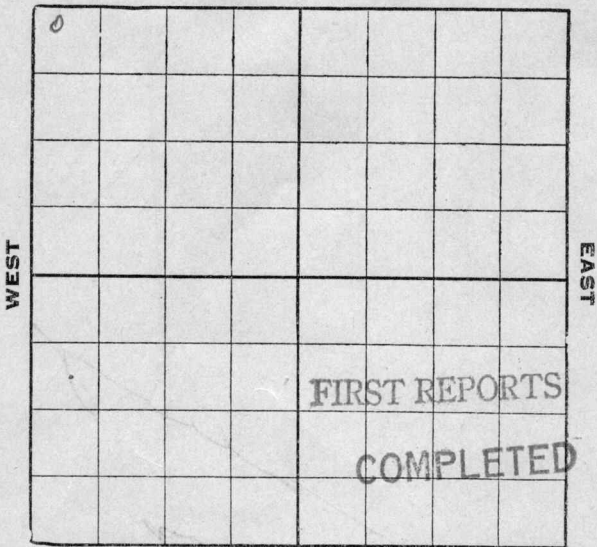

SOUTH

Location _____ Cased _____ in. _____ ft.

Rig up _____ Mach _____
Productive Horizons
From _____ To _____

Drilling at _____ top hole 1685

Fishing at _____ band 1700-1726

U. R. to _____

S. D. at _____

Natural production _____ Bbls. per _____ hours

Pumping _____ Gas _____ Cu. ft. per 24 hours

Gauge press. _____ lbs. Total depth _____

Were samples collected 60/35 lbs.

Remarks:

10/16/22

Sherwood