

Woodson


KANSAS

SECTION 5 TOWNSHIP 24 RANGE 14E

WELL NO. #1 H.D. Stevenson (KGS DRL)

COMPANY The Pure Oil Co.


NORTH C NE NW

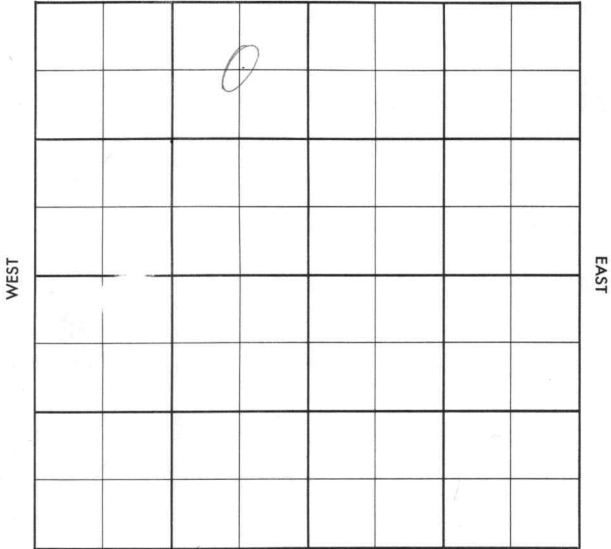

SOUTH

County Woodson Elev. 1199 DF
 Sec. 5 Twp. 24 Rge. 14E
 Company The Pure Oil Co.
 Farm Name H. D. Stevenson No. 17

TOPS	DEPTH	LOG	DATUM	Loc. in Sec.
Anh.				C NE NW
Tp.				
H.				
Tr.				
Dg.				
Bl.				
L.				Geol.
K.C.				Contr.
B.K.C.				Barnard Tools
Ce.				Pool
C.				Winterschied
M.	<u>1688</u>			
M.				
K.				
Mz.				
Ms.				
V.				
S.				
S.				
A.				
R.				
Pe.				
G.				
T.D.	<u>1738</u>			

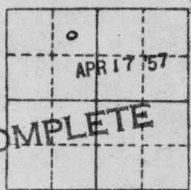

Date Comm.

Location APR 3 57 3-27-57 8 1/8

8 1/65 17 1200 APR 10 57 crd 1305

-30 rec 25' 5 1/2 1738/150

APR 17 57 CO 84/1698-1712 13

\$ 49 B0 + 44 B Acid wtr

\$ 5 B0 + 10 B Acid wtr 6 hrs

Pop. P. 20 B0pd + 40 Bwpd