


Company Pure Oil

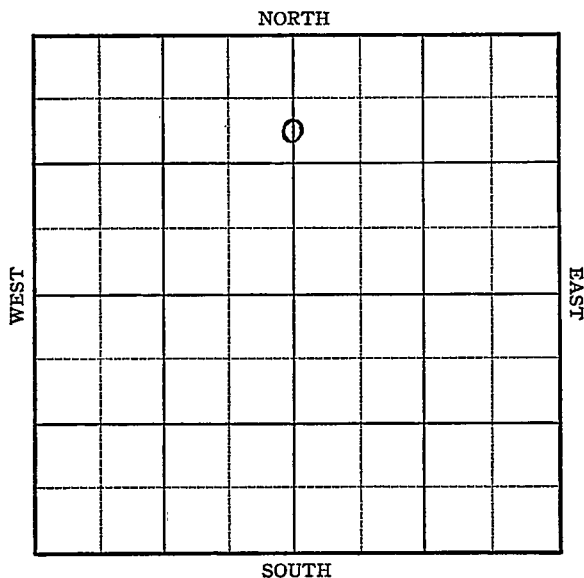

Map No. 17 Sec. 5 Twp. 24 R. 14EWell No. 10 StevensonPure Oil


Company

Contractor

FIRST REPORT

C $S\frac{1}{2}$ $N\frac{1}{2}$ $N\frac{1}{2}$ 990 Ft. from N. Line Ft. from S. Line2640 Ft. from E. Line Ft. from W. Line

SECTION PLAT

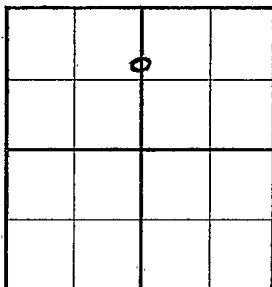Location Rig up

Drilling and Remarks:

RUM

RECORD

Cased in., ft.Sand Gas Oil Total Depth

PRODUCTION

1st 24 hrs. Nat. 1st 24 hrs. after shot Gas Cu. Ft.Dry Hole Abandoned

Date

NOV 17 1937 19H. D. Hatfield Scout

Woodson

KANSAS

Map No. 17 Sec. 5 Twp. 24 R. 14EWell No. 10 Stevenson

Pure Oil

Company

Contractor

COMPLETED

SECTION PLAT

990 C S $\frac{1}{2}$ N $\frac{1}{2}$ N $\frac{1}{2}$
Ft. from N. Line

Ft. from S. Line

2640 Ft. from E. Line

Ft. from W. Line

Location

Rig up

Drilling and Remarks:

3000 acid
8 oil
10 water

RECORD

Cased 6 in. 1709 ft.~~Sand~~ MISS 1708

Gas

Oil

Total Depth 1739

PRODUCTION

1st 24 hrs. Nat.

1st 24 hrs. after shot

Gas Cu. Ft.

Dry Hole

Abandoned

Date

DEC 22 1937 19 H. D. Hatfield Scout