

Barton

KANSAS

FORM 51 25M 3-49 PETROL

O. W. D. D

Section 1 Township 17 Range 11W

Well No. #1 ^{ENLY} Smith

Company Imperial Oil
R. L. Williams Oil

NORTH

10

WEST

EAST

0

2

SOUTH


O. W. D. D Barton
Sec. 1 Twp. 17 R. 11W

Well No. #1 ^{Ehly} ~~Smith~~ Farm

~~Imperial Oil~~
~~R. L. Williams Oil~~ Company

Harms & Knight Contractor

990' Ft. from N. Line
Ft. from S. Line
Ft. from E. Line
330' Ft. from W. Line

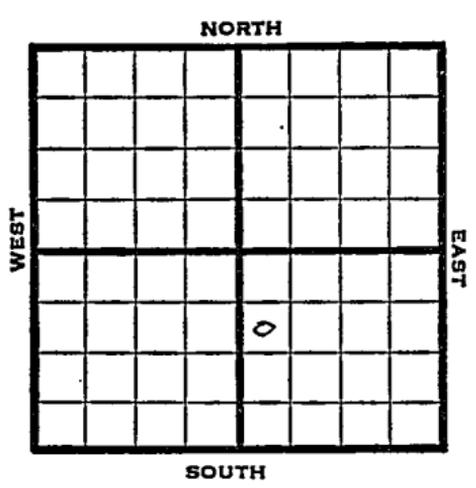

SW NW SE

1950 Elev 1995' REPORT

3/15 Drlg.
4/12 TD 3178'
8" @ 246'
Heeb 2980'
Br L 3082'
Lans 3101'
5" @ 3174'
303 BOPD
Comp

COMPLETED O. W. D. D

1951
2/28 Lans. 3101' OTD 3178
5" @ 3174
Gong. 3384
Arb. 3411
Drlg. 3416'

4/11 D & A TD 3438' Lans. 3101',
OTD 3178', 5" @ 3174', Gong 3384',
Arb. 3411' TD 3432'
S/1 BOPH P/5 BOPD DD 3438' 1500 A
8 BOPD PB 3300' 6/3280-82
18/ 3191-95 water 12/3125-28 500 A
D & A

ABANDONED

Map No. _____ Sec. 1 Twp. 17 R. 11WWell No. 1 Smith

_____ R. L. Williams Oil _____ Company

_____ Harms & Knight _____ Contractor

SW NW SE

_____ 990 Ft. from N. Line

_____ Ft. from S. Line

_____ Ft. from E. Line

_____ 330 Ft. from W. Line

Barton County

SECTION PLAT



Location _____

Rig up _____

Drilling and Remarks:

drlg.

RECORD

Cased _____ in., _____ ft.

Sand _____

Gas _____

Oil _____

Total Depth _____

PRODUCTION

1st 24 hrs. Nat. _____

1st 24 hrs. after shot _____

Gas _____ Cu. Ft.

Dry Hole _____

Abandoned _____

Date

MAR 15 1950 19J. E. TYRA Scout

Map No. _____ Sec. 1 Twp. 17 R. 11W

Well No. 1 Smith

R. L. Williams Company

_____ Contractor

SW NW SE


E. 1995
SECTION PLAT

990 Ft. from N. Line

_____ Ft. from S. Line

_____ Ft. from E. Line

330 Ft. from W. Line

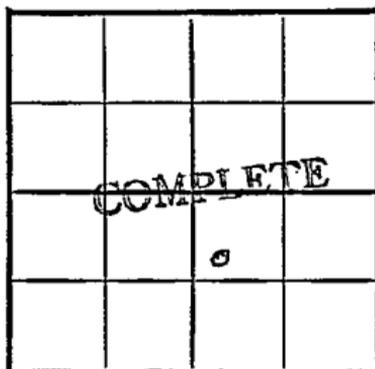

Barton County

Location _____

Rig up _____

Drilling and Remarks:

8" @ 246
Hub 2980
Br 3082
Lens 3101
5" @ 3174
303 BOPD

RECORD

Cased _____ in., _____ ft.

Sand _____

Gas _____

Oil _____

Total Depth 3178

PRODUCTION

1st 24 hrs. Nat. _____

1st 24 hrs. after shot _____

Gas _____ Cu. Ft.

Dry Hole _____

Abandoned _____

Date

APR 12 1950 19

J. E. TYRA Scout