

Section 3 Township 12 Range 20WWell No. 1 - F. J. HamburgCompany Texas Company

NORTH

WEST

EAST

D

SOUTH

Ellis

KANSAS ✓

Sec. 3 Twp. 12 R. 20 WWell No. # 1 F. J. Hamburg Farm

Texas Company

Company

Powell Drlg.

Contractor

Ft. from N. Line

990


Ft. from S. Line

330

Ft. from E. Line

Ft. from W. Line

NE SE SW

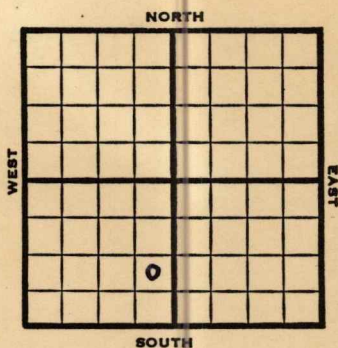

1952

Elev. 2195' REPORT

12/30

Spud 12-27-52
10" @ 259 WOC

1/1

WOC

1/8

Top 3240 DST 3283-97 1 Hr. 90' SW 1030#
DST 3283-97 1 Hr. 90' SW 1030# Ø3410

1/14

Spud 12-27-52

D&A TD 3920

10" @ 259

Top 3240

DST 3283-97, opn 1 hr., rec.
90' sw 1030#

Heeb 3490, Lans 3536

DST 3582-3608, opn 1 hr., Rec.
8' mud, 195#DST 3609-25, opn 1½ hr., rec.
130' s w, 970#

Cong. 3841, Arb. 3895

TD 3920

D&A

ABANDONED

Sec. **3** (Blk.) **12** (Sur.) **20W** Map No.

Well No. 1 Farm F. J. Hamburg

FIRST REPORT

Spudding Date 12-27-52

10" @ 259 WOC

County Ellis State Kansas
 Sec. 3 (Blk. 12 (Sur. 20W Map No.
 Twp. Rge.

Operator Texas Company

Well No. 1 Farm F. J. Hamburg

Elev. 2195 Location NE SE SW



990 Ft. From S Line SW

330 Ft. From E Line Quarter

1st. Report

Completion JAN 14 1953

Remarks

Powell D_rlg. - Contr.

Spudding Date 12-27-52

Drlg. Data D & A TD 3920

10" @ 259 Top. 3240 DST 3283-97

open 1 hr. Rec. 90' sw 1030#

Heeb. 3490 Lans. 3536 DST 3582-3608

open 1 hr. Rec. 8' mud 195#

DST 3609-25 open 1½ hr. Rec. 130' sw

970# Cong. 3841 Arb. 3895 TD 3920

D & A

J. G. McGEHEE