

KANSAS

Form 51-5M-7-40-Palace


Barton

Section 2 Township 17 Range 11-W

Well No. #1 Burmeister

Company Carter Oil

NORTH Kraft Pool

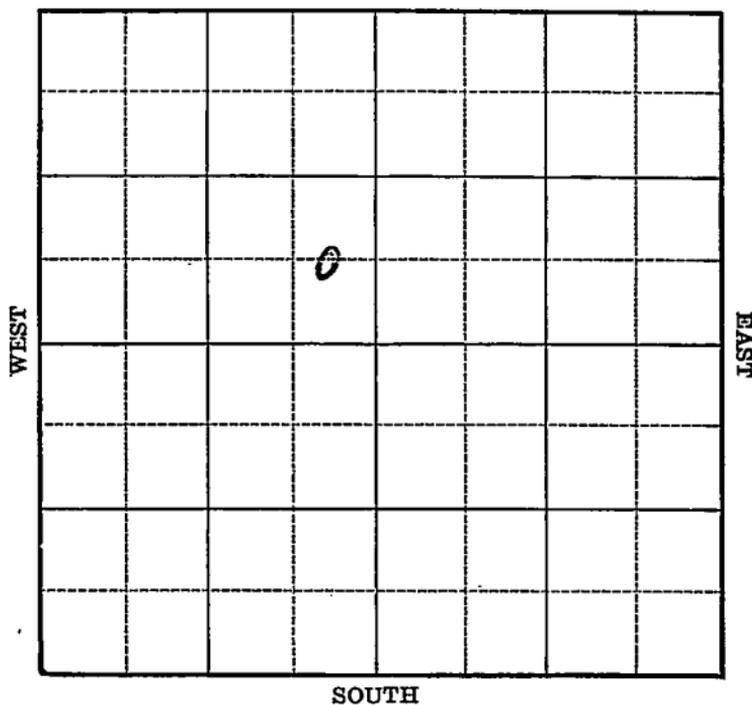

Sec. 2 Twp. 17 R. 11-WWell No. #1 Burmeister Farm
Carter Oil Company


(Kraft)

_____ Ft. from N. Line

660 Ft. from S. Line330 Ft. from E. Line

_____ Ft. from W. Line

Elev. 1938

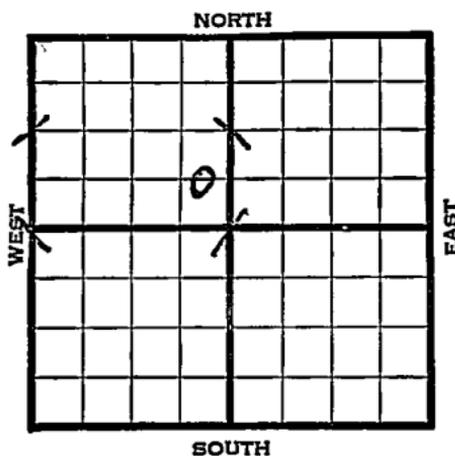

1940	REPORT
12/4	Cellar.
12/12	Derrick.
12/19	10" - 276' Drlg. 2147'
12/26	Topeka 2720' Lans. 3075'
	Drlg. 3161'
1941	
1/2	Arb. 3359-67' T.D. 5" - 3361'
	1 bailer oil per hour.
1/9	T.D. 3380' 3 bbls. per hour 12
	hours. 500 acid. 1000 acid.
	7 bbls. per hour.
1/15	Arb. 3359'
	5" - 3361'
	T.D. 3380'
	1500 acid.
	Potential 350 bbls., pump.
	45. Gravity
	COMPLETED

Map No. 55 Sec. 2 Twp. 17 R. 11WWell No. 1 BurmeisterCarter Oil

Company

Contractor

FIRST REPORT

C E L S E N W

_____ Ft. from N. Line

660 Ft. from S. Line330 Ft. from E. Line

_____ Ft. from W. Line

SECTION PLAT

KRAFT POOL

Location _____

Rig up _____

Drilling and Remarks:

Cellar

RECORD

Cased _____ in., _____ ft.

Sand _____

Gas _____

Oil _____

Total Depth _____

PRODUCTION

1st 24 hrs. Nat. _____

1st 24 hrs. after shot _____

Gas _____ Cu. Ft.

Dry Hole _____

Abandoned _____

Date

DEC 4 1940S. J. LEWIS Scout

Map No. 55 Sec. 2 Twp. 17 R. 11WWell No. 1 BurmeisterCarter Oil

Company

Contractor

COMPLETED

C E L SE NW

_____ Ft. from N. Line

660 Ft. from S. Line330 Ft. from E. Line

_____ Ft. from W. Line

SECTION PLAT

KRAFT POOL

Location _____

Rig up _____

Drilling and Remarks:

*Log 3359**5" @ 3361**1500 acid**Pump 350 Pk.**45° Gr.***RECORD**

Cased _____ in., _____ ft.

Sand _____

Gas _____

Oil _____

Total Depth 3380**PRODUCTION**

1st 24 hrs. Nat. _____

1st 24 hrs. after shot _____

Gas _____ Cu. Ft.

Dry Hole _____

Abandoned _____

Date

JAN 15 1941 19S. I. LEWIS

Scout