


KANSAS

SECTION 5 TOWNSHIP 12S RANGE 20W

WELL NO. #1 Deulcher


COMPANY Sierra & Halliburton

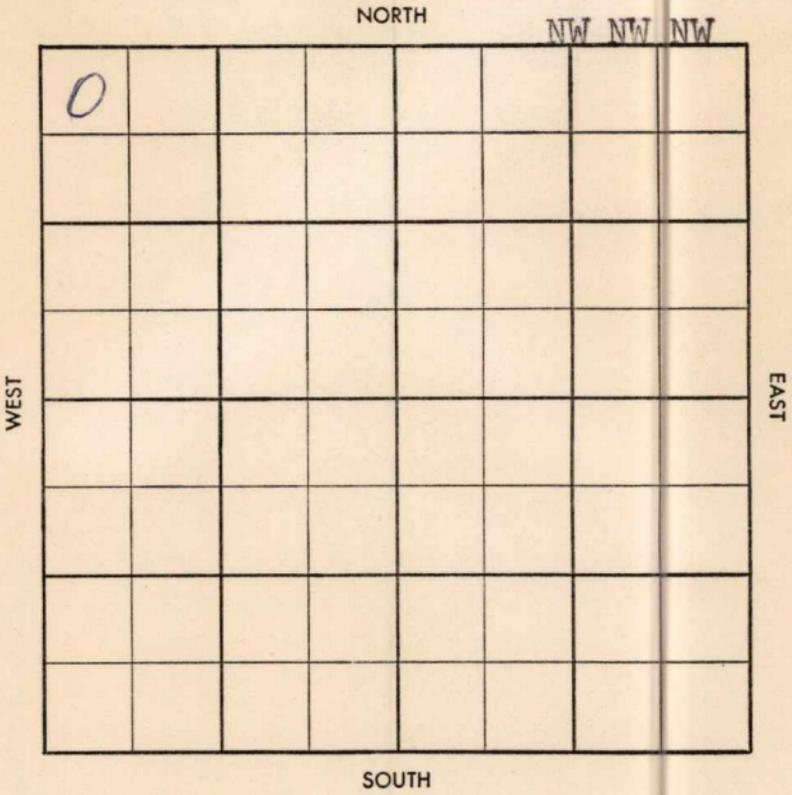

WILDCAT

S-513-B

County Ellis Elev. _____ Co. _____
 Sec. 5 Twp. 12 Rge. 20W
 Company Sierra & Halliburton
 Farm Name Deulcher No. 1

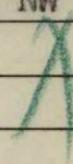TOPS	DEPTH	LOG	DATUM	Loc. in Sec.	
Anh. _____				NW NW NW	
Tp. _____					
H. _____					
Tr. _____					
Dg. _____					
B.L. _____					
L. _____					
K.C. _____					Geol. _____
B.K.C. _____					Contr. _____
C. _____					<u>Sierra Drlg.</u>
M. _____					Pool _____
M. _____				<u>Wildcat</u>	
K. _____					
Mz. _____					
Mq. _____					
V. _____					
S. _____					
S. _____					
A. _____					
R. _____				No. _____	
Pf. _____				Sec. _____	
G. _____				T. _____	
T.D. _____				R. _____	

Date Comm. _____ (Texas Co. - FO)
ready to MI 3840' Arb.

Twp. ~~X~~ Pool ~~X~~

Co. ~~X~~ Facet ~~X~~

S-513-B

County Ellis Elev 22540F 225790

Sec. 5 Twp. 12 Rge. 20W

Company Sierra & Halliburton

Farm Name Deulcher No. 1

TOPS	DEPTH	LOG	DATUM
Anh.	1670		
Tp.	3307		
H.	3525		
Tr.	3542		
Dg.			
B.L.			
L.	3563		
K.C.			
B.K.C.	3802		
Ce.			
C.	3863		
M.			
M.			
K.			
Mz.			
Mq.			
V.			
S.			
S.			
A.	3922		
R.			
Pf.			
G.			
T.D.	3950		

Loc. in Sec. NW NW NW

Geol. _____

Contr. Sierra Drlg.

Pool Wildcat

ABANDONED
MAR 27 1958

Date Comm. 3-13-58 (Texas Co. - FO)

ready to MI 8840' Arb. MAR 19 58 8" 282/150

3180 MAR 26 58 log

DBA