

KANSAS


Barton

FORM 51 5M 1-42 PETROL

Section 2 Township 17 Range 11-W

Well No. #1 Burmeister

Company Winkler-Koch

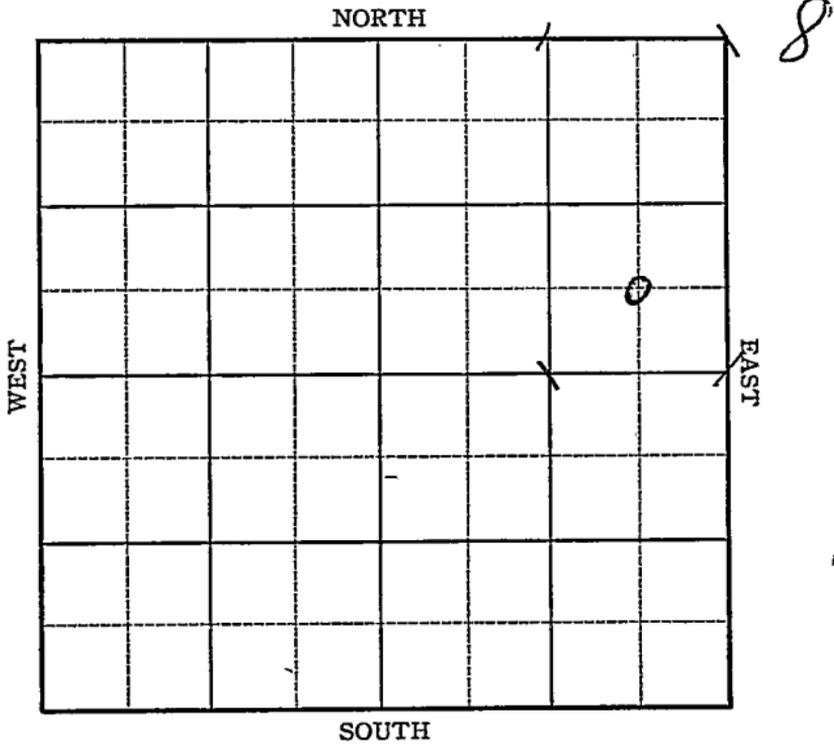

KANSAS

Sec. 2 Twp. 17 R. Barton 11-W

Well No. #1 Burmeister Farm

Winkler-Koch Company


Kraft Prusa

 Ft. from N. Line

660 Ft. from S. Line

660 Ft. from E. Line

 Ft. from W. Line

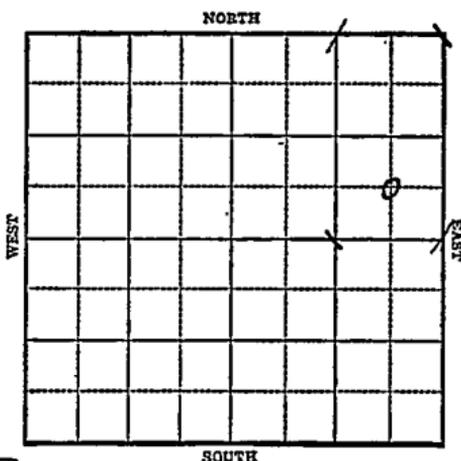

Elev. 1952

1943

R E P O R T

6/23 8" @ 312'
Drlg. 710'

6/30 Drlg. 2660'

7/7 Arb. 3410
T.D. 3422'

ABANDONED

KANSAS

Barton

Map No. 55 Sec. 2 Twp. 17 R. 11WWell No. 1 BurmeisterWinkler-Koch

Company

FIRST REPORT

Contractor

C SE NE

Ft. from N. Line

660

Ft. from S. Line

660

Ft. from E. Line

Ft. from W. Line

SECTION PLAT

			o
			.

KRAFT PRUSA POOL

Location _____

Rig up _____

Drilling and Remarks:

8"-312'

Drlg. 710'

RECORD

Cased _____ in., _____ ft.

Sand _____

Gas _____

Oil _____

Total Depth _____

PRODUCTION

1st 24 hrs. Nat. _____

1st 24 hrs. after shot _____

Gas _____ Cu. Ft.

Dry Hole _____

Abandoned _____

Date

JUN 23 1943 19

S. J. LEWIS Scout.

KANSAS

Map No. 55 Sec. 2 Twp. 17 R. 11W

Well No. 1 Burmeister

Winkler-Koch Company

ABANDONED Contractor

C SE NE

SECTION PLAT

			o

_____ Ft. from N. Line

660 Ft. from S. Line

660 Ft. from E. Line

_____ Ft. from W. Line

KRAFT PRUSA POOL

Location _____

Rig up _____

Drilling and Remarks:

Cr 8410

RECORD

Cased _____ in., _____ ft.

Sand _____

Gas _____

Oil _____

Total Depth 3422

PRODUCTION

1st 24 hrs. Nat. _____

1st 24 hrs. after shot _____

Gas _____ Cu. Ft.

Dry Hole _____

Abandoned _____

Date

Jul 7 1943 19

S. J. LEWIS Scout