

KANSAS

Barton


Form 51-5M-7-40-Palace

Section 2 Township 17 Range 11-W

Well No. #1 Burmeister 'A' (KGS ORL)

Company Texas

NORTH Kraft Pool

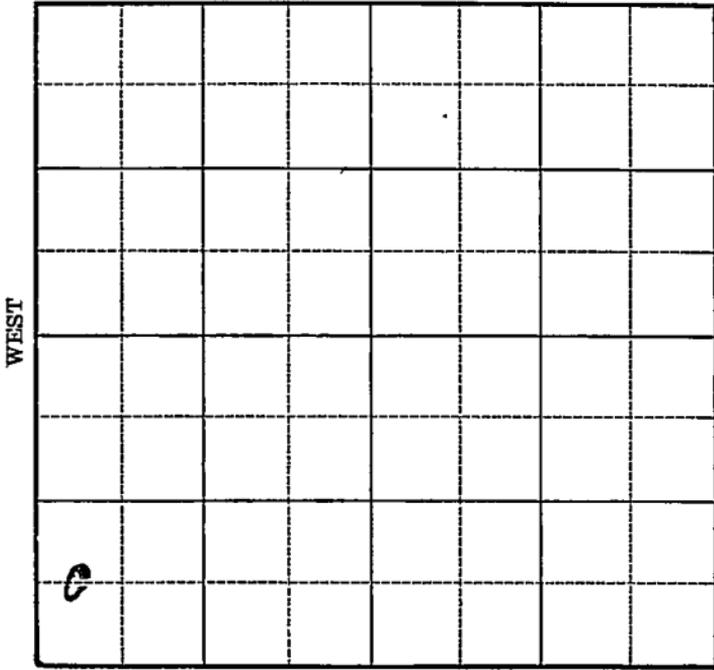

SOUTH

Sec. 2 Twp. 17 R. 11-W

Well No. #1 Burmeister (A) (K65 MRL) Farm

Texas Company

(Kraft)


_____ Ft. from N. Line

66.0 Ft. from S. Line

_____ Ft. from E. Line

330 Ft. from W. Line

Elev. 1889

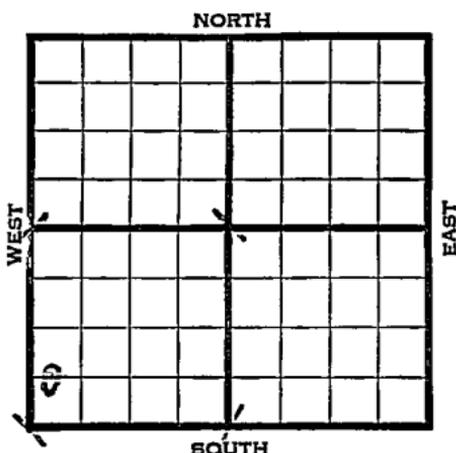

1940	REPORT
9/25	10" - 288'
	Drlg. 2125'
10/3	Lansing 3036' Arb. 3303-06' T.D.
	7" - 3303'
10/9	Arb. 3303'
	7" - 3303'
	T.D. 3308'
	Depthograph potential 3625 bbls.
	Maximum 3000 bbls.
	COMPLETED

Map No. 55 Sec. 2 Twp. 17 R. 11WWell No. 1 Burmeister (A) (KGS DRL)

Texas

Company

Contractor

FIRST REPORTC $W\frac{1}{2}$ SW SW

_____ Ft. from N. Line

660 Ft. from S. Line

_____ Ft. from E. Line

330 Ft. from W. Line

KRAFT POOL

SECTION PLAT

Location _____

Rig up _____

Drilling and Remarks:

10" - 288Drlg. 2125**RECORD**

Cased _____ in., _____ ft.

Sand _____

Gas _____

Oil _____

Total Depth _____

PRODUCTION

1st 24 hrs. Nat. _____

1st 24 hrs. after shot _____

Gas _____ Cu. Ft.

Dry Hole _____

Abandoned _____

Date

SEP 25 1940 19S. J. LEWIS Scout

Map No. 55 Sec. 2 Twp. 17 R. 11W

Well No. 1 Burmeister (A) (KGS PRL)

Texas

Company

Contractor

COMPLETED

C $W\frac{1}{2}$ SW SW

_____ Ft. from N. Line

660 Ft. from S. Line

_____ Ft. from E. Line

330 Ft. from W. Line

KRAFT POOL

SECTION PLAT

Location _____

Rig up _____

Drilling and Remarks:

See #3303

7" @ 3303

Depth. Pat #3625

May 3000

RECORD

Cased _____ in., _____ ft.

Sand _____

Gas _____

Oil _____

Total Depth 3308

PRODUCTION

1st 24 hrs. Nat. _____

1st 24 hrs. after shot _____

Gas _____ Cu. Ft.

Dry Hole _____

Abandoned _____

Date

Oct 6 1940 19

S. J. LEWIS Scout