
Barton KANSAS

Form 51—5M—7-39—Palace

Section 2 Township 17 Range 11-W

Well No. #1 Kraft

Company National Refg. et al

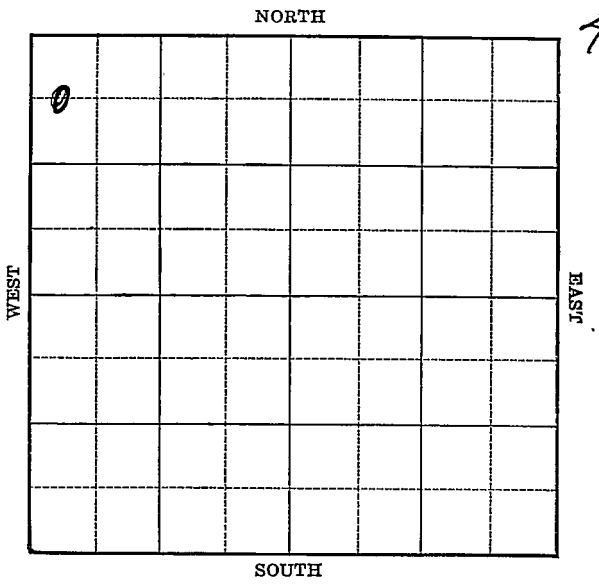

FORM 252-A 5M 2-40 KANSAS -- Barton

Sec. 2 Twp. 17 R. 11-W

Well No. #1 Kraft Farm

National Refg. et al Company


(Kraft)

660 Ft. from N. Line

_____ Ft. from S. Line

_____ Ft. from E. Line

330 Ft. from W. Line

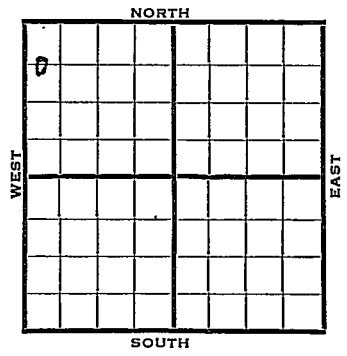

Elev. 1904

1940	REPORT
4/3	Location
4/12	Rigging cable rig.
4/18	Spud & SD.
4/25	Drlg. 400'
5/2	Anhy 706' 12½" - 717'
	Drlg. 960'
5/9	Drlg. 1980'
5/16	10" - 2034' Drlg. 2550'
5/23	Topeka 2720' T.D. 2980' C.O.
5/29	Arb. 3377'
	7" - 3345'
	T.D. 3400'
	H.F.W.
	ABANDONED

Form 26—1M Bks.—2-29 Barton KANSAS

Map No. 53 Sec. 2 Twp. 17 R. 11W

Well No. 1 Kraft

National Refining etal Company

Contractor

FIRST REPORT

C W L NW NW

660 Ft. from N. Line


_____ Ft. from S. Line

_____ Ft. from E. Line

330 Ft. from W. Line

KRAFT POOL

SECTION PLAT

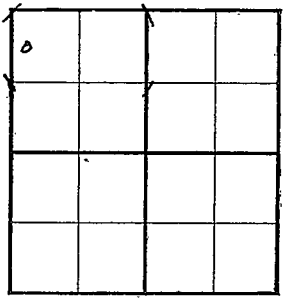

Location X

Rig up

Drilling and Remarks:

RECORD

Cased ____ in., ____ ft.

Sand

Gas

Oil

Total Depth

PRODUCTION

1st 24 hrs. Nat.

1st 24 hrs. after shot

Gas ____ Cu. Ft.

Dry Hole

Abandoned

Date

APR 3 1940 19

S. J. LEWIS Scout

Form 26—200 Bks.—1-40—Palace Barton KANSAS

Map No. 55 Sec. 2 Twp. 17 R. 11W

Well No. 1 Kraft

National Refining etal Company

Contractor

ABANDONED

C W L NW NW

660 Ft. from N. Line


_____ Ft. from S. Line

_____ Ft. from E. Line

330 Ft. from W. Line

KRAFT POOL

SECTION PLAT

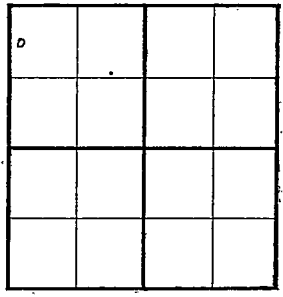

Location _____

Rig up _____

Drilling and Remarks:

Cr X 3377

7" @ 3345

HFW.

RECORD

Cased _____ in., _____ ft.

Sand _____

Gas _____

Oil _____

Total Depth 3400

PRODUCTION

1st 24 hrs. Nat. _____

1st 24 hrs. after shot _____

Gas _____ Cu. Ft.

Dry Hole _____

Abandoned _____

Date

MAY 29 1940 19

S. J. LEWIS Scout