

KANSAS

Form 51-5M-7-40-Palace

Barton

Section 2 Township 17 Range 11-W

Well No. #2 Burmeister "A"

Company Texas


Kraft Pool

NORTH

WEST

EAST

SOUTH

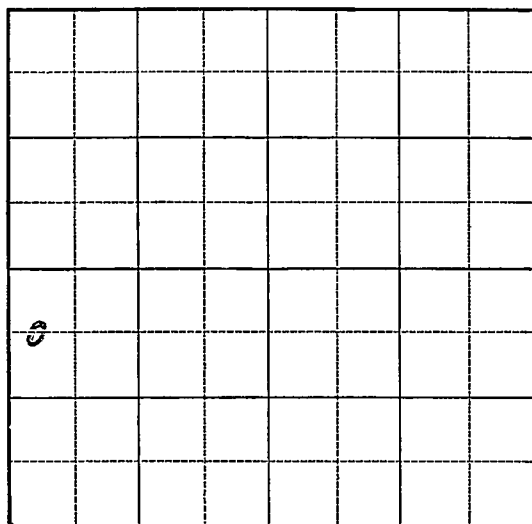

Map No. 55 Sec. 2 Twp. 17 R. 11WWell No. 2 Burmeister "A"Texas

Company

Contractor

FIRST REPORT

C W L NW SW

660 Ft. from N. Line Ft. from S. Line Ft. from E. Line330 Ft. from W. Line

SECTION PLAT

KRAFT POOL

Location Rig up

Drilling and Remarks:

Cellar

RECORD

Cased in., ft.Sand Gas Oil Total Depth

PRODUCTION

1st 24 hrs. Nat. 1st 24 hrs. after shot Gas Cu. Ft.Dry Hole Abandoned

Date

NOV 13 1940 19S I LEWIS Scout

Map No. 55 Sec. 2 Twp. 17 R. 11WWell No. 2 Burmeister "A"

Texas

Company

Contractor

COMPLETED

C W L NW SW

SECTION PLAT

660 Ft. from N. Line

_____ Ft. from S. Line

_____ Ft. from E. Line

330 Ft. from W. Line

KRAFT POOL

0			

Location _____

Rig up _____

Drilling and Remarks:

*Cor & 3288**7" C 3288**Depth P & 2210**43.6 hr.*

RECORD

Cased _____ in., _____ ft.

Sand _____

Gas _____

Oil _____

Total Depth 3300

PRODUCTION

1st 24 hrs. Nat. _____

1st 24 hrs. after shot _____

Gas _____ Cu. Ft.

Dry Hole _____

Abandoned _____

Date

DEC 11 1940 19 S. J. LEWIS Scout