

# KANSAS


Barton

FORM 51 5M 10-41 PETROL

Section 2 Township 17-S Range 11-W

Well No. #3 Burmeister

Company Carter Oil

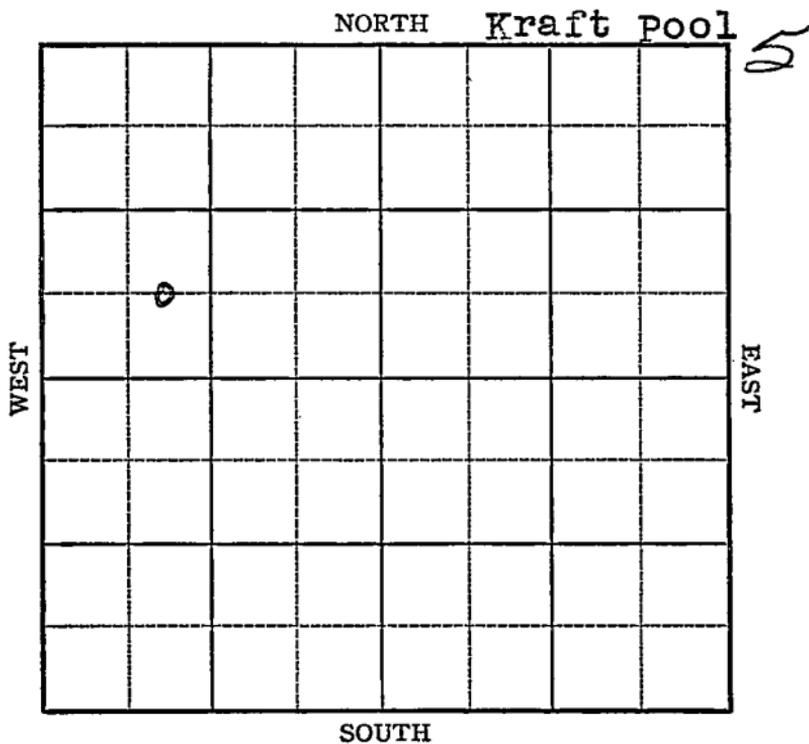

Sec. 2 Twp. 17-S R. 11-W

Well No. #3 Burmeister Farm

Carter Oil Company

(Kraft)


\_\_\_\_\_ Ft. from N. Line

660 Ft. from S. Line

\_\_\_\_\_ Ft. from E. Line

990 Ft. from W. Line

Elev. 1900

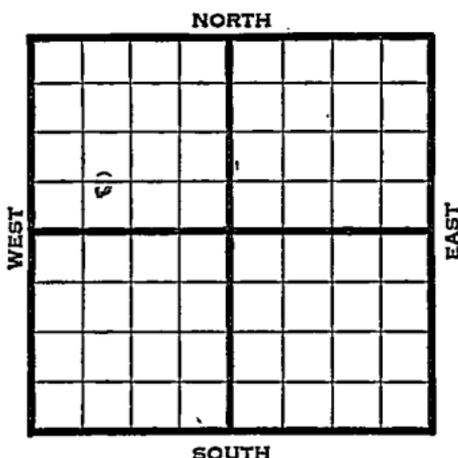

1941	REPORT
12/3	Bldg. Derrick.
12/11	8" @ 268 Drlg. 1789.
12/18	Topeka 2680
	Lans. 3051
	Drlg. 3189
12/24	Arb. 3330-34' T.D. 5" - 3330' RUST.
12/31	T.D. 3346' 700' oil 3 hours.
	3000 acid.
1942	
1/7	Arb. 3330'
	5" - 3330'
	T.D. 3346'
	3000 acid.
	Potential 423 bbls., pump.
	42. Gravity
	<b>COMPLETED</b>

Map No. 55 Sec. 2 Twp. 17S R. 11WWell No. 3 BurmeisterCarter Oil CompanyFIRST REPORT ContractorC E $\frac{1}{2}$  SW NW

## SECTION PLAT

         Ft. from N. Line660 Ft. from S. Line         Ft. from E. Line990 Ft. from W. Line

o			

KRAFT POOL

Location         Rig up         

Drilling and Remarks:

Building Derrick

## RECORD

Cased          in.,          ft.Sand         Gas         Oil         Total Depth         

## PRODUCTION

1st 24 hrs. Nat.         1st 24 hrs. after shot         Gas          Cu. Ft.Dry Hole         Abandoned         

Date

DEC 3 1941 19S. J. LEWIS Scout

Barton

KANSAS

Map No. 155 Sec. 2 Twp. 17S R. 11WWell No. 3 Burmeister

Carter Oil

Company

COMPLETED

Contractor

C  $E\frac{1}{2}$  SW NW

## SECTION PLAT


\_\_\_\_\_ Ft. from N. Line

660 Ft. from S. Line

\_\_\_\_\_ Ft. from E. Line

990 Ft. from W. Line

KRAFT POOL

Location \_\_\_\_\_

Rig up \_\_\_\_\_

Drilling and Remarks:

*Cor 3330*  
*5' @ 3330*  
*3000 Acid*  
*Pump #23 PD*

*42 @ 42*

## RECORD

Cased \_\_\_\_\_ in., \_\_\_\_\_ ft.

Sand \_\_\_\_\_

Gas \_\_\_\_\_

Oil \_\_\_\_\_

Total Depth 3346

## PRODUCTION

1st 24 hrs. Nat. \_\_\_\_\_

1st 24 hrs. after shot \_\_\_\_\_

Gas \_\_\_\_\_ Cu. Ft.

Dry Hole \_\_\_\_\_

Abandoned \_\_\_\_\_

Date

JAN 7 1942 19

S. J. LEWIS Scout