

# KANSAS


Barton

FORM 51 5M 4-41 PETROL

Section 2 Township 17 Range 11-W

Well No. 4 Burmeister "A"

Company Texas Kraft Pool

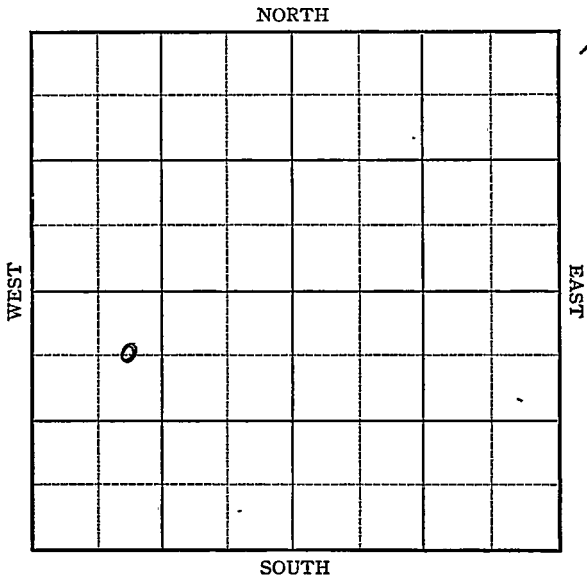

Sec. 2 Twp. 17 R. 11-W

Well No. #4 Burmeister "A" Farm

Texas Company

(Kraft)


660 Ft. from N. Line

\_\_\_\_\_ Ft. from S. Line

\_\_\_\_\_ Ft. from E. Line

990 Ft. from W. Line

Elev. 1895

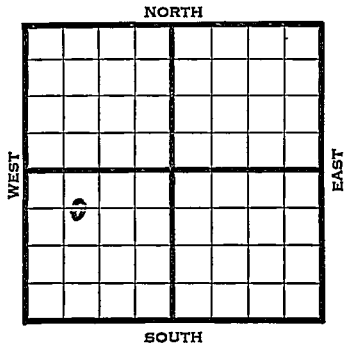

1941	REPORT
4/23	Derrick.
5/1	10" - 268' Drlg. 1650'
5/8	Arb. 3308-10' T.D. 7" - 3308'
	RUST.
5/15	T.D. 3323' Swab 25 bbls. per
	hour for 6 hours.
5/21	Arb. 3308'
	7" - 3308'
	T.D. 3323'
	Depthograph potential 762 bbls.
	43.6 Gravity
	<b>COMPLETED</b>

Map No. 55 Sec. 2 Twp. 17 R. 11W

Well No. 4 Burmeister "A"

Texas

Company \_\_\_\_\_

**FIRST REPORT**

Contractor \_\_\_\_\_

C E L NW SW

**SECTION PLAT**

660 Ft. from N. Line

\_\_\_\_\_ Ft. from S. Line

\_\_\_\_\_ Ft. from E. Line

990 Ft. from W. Line

δ			

**KRAFT POOL**

Location \_\_\_\_\_

Rig up \_\_\_\_\_

Drilling and Remarks:

Derrick

**RECORD**

Cased \_\_\_\_\_ in., \_\_\_\_\_ ft.

Sand \_\_\_\_\_

Gas \_\_\_\_\_

Oil \_\_\_\_\_

Total Depth \_\_\_\_\_

**PRODUCTION**

1st 24 hrs. Nat. \_\_\_\_\_

1st 24 hrs. after shot \_\_\_\_\_

Gas \_\_\_\_\_ Cu. Ft.

Dry Hole \_\_\_\_\_

Abandoned \_\_\_\_\_

Date

APR 23 1941

19

S. J. LEWIS Scout

Map No. 55 Sec. 2 Twp. 17 R. 11W

Well No. 4 Burmeister "A"

Texas Company

COMPLETED Contractor

C E L NW SW

660 Ft. from N. Line

\_\_\_\_\_ Ft. from S. Line

\_\_\_\_\_ Ft. from E. Line

990 Ft. from W. Line

SECTION PLAT


KRAFT POOL

Location \_\_\_\_\_

Rig up \_\_\_\_\_

Drilling and Remarks:

*Cu 83308*  
*7" @ 8308*  
*Dept. H. P. 8762*

*43 5/8*

RECORD

Cased \_\_\_\_\_ in., \_\_\_\_\_ ft.

Sand \_\_\_\_\_

Gas \_\_\_\_\_

Oil \_\_\_\_\_

Total Depth 9323

PRODUCTION

1st 24 hrs. Nat. \_\_\_\_\_

1st 24 hrs. after shot \_\_\_\_\_

Gas \_\_\_\_\_ Cu. Ft.

Dry Hole \_\_\_\_\_

Abandoned \_\_\_\_\_

Date

MAY 21 1941 19

S. J. LEWIS Scout