


Barton

Section 3 Township 17 Range 11-W

Well No. 1 - Burniester

Company Darby

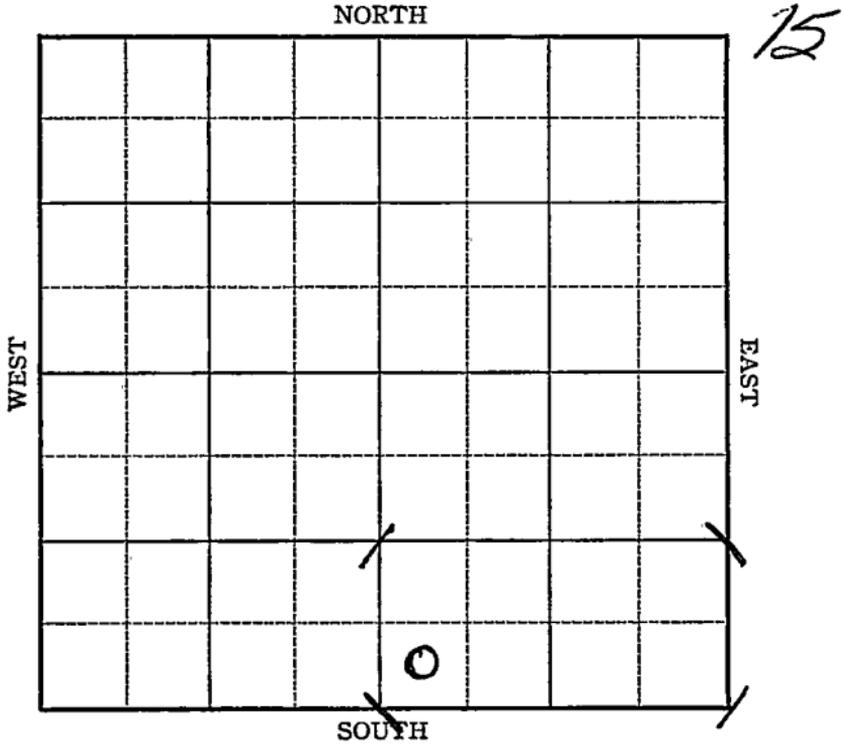

Sec. 3 Twp. 17 R. 11-W

Well No. #1 Burmiester Farm

Darby Company


\_\_\_\_\_ Ft. from N. Line

330 Ft. from S. Line

\_\_\_\_\_ Ft. from E. Line

330 Ft. from W. Line

Elev. 1881

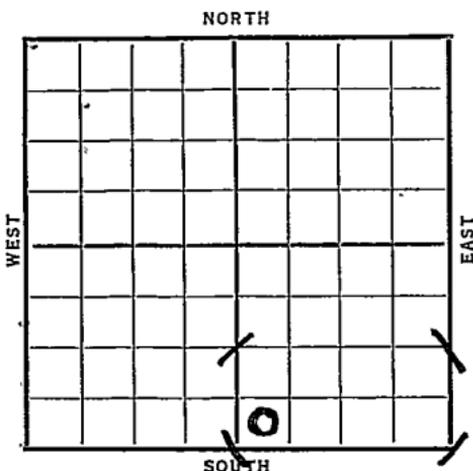

Date	REPORT
1937	
6/9	Location
6/19	B. Cable rig.
6/25	Rig'n.
7/2	15" @ 270'. Drlg. 715'.
7/9	12" @ 682'. Drlg. 1750'.
7/16	10" @ 2006'. Drlg. 2460'.
7/23	Fsg. 2900'.
7/30	Est. 2½ M gas 2918-2922'.
	8" @ 2922'. K.C. 2995'.
	T.D. 3005'. U.R. 8".
8/6	S. G. 3020-30'. 8" @ 3066'.
	Drlg. 3105'.
8/13	S.O. 3107-12'. 8" @ 3099'.
	Clean out.
8/20	6" @ 3198'. Cong. 3277'.
	Sil. 3283'. S.O. 3284' T.D.
	U. R. 6".
	<b>OVER</b>

1937

8/28

6" @ 3283'. 300' oil 1 hr  
at 3286'. 3000' oil 6 hrs  
at 3298'. 2000 acid.

9/1

6" @ 3283'.  
Sil. 3283'.  
T.D. 3298'.  
2000 acid.  
Pot. 1817 bbls.

COMPLETED

*Barton* **KANSAS**

Map No. 53 Sec. 3 Twp. 17 R. 11 <sup>W</sup>

Well No. 1 - Burnmaster

Darby Company

Contractor

**FIRST REPORT**

**SECTION PLAT**

\_\_\_\_\_ Ft. from N. Line

330 Ft. from S. Line

1 Ft. from E. Line

330 Ft. from W. Line


Location ✓

Rig up \_\_\_\_\_

Drilling and Remarks:

**RECORD**

Cased \_\_\_\_\_ in., \_\_\_\_\_ ft.

Sand \_\_\_\_\_

Gas \_\_\_\_\_

Oil \_\_\_\_\_

Total Depth \_\_\_\_\_

**PRODUCTION**

1st 24 hrs. Nat. \_\_\_\_\_

1st 24 hrs. after shot. \_\_\_\_\_

Gas \_\_\_\_\_ Cu. Ft.

Dry Hole \_\_\_\_\_

Abandoned \_\_\_\_\_

Date

JUN 9 1937 19

H. D. Hatfield Scout

*Barton* KANSAS

Map No. \_\_\_\_\_ Sec. 3 Twp. 17 R. 11W

Well No. 1-Burmiester

Darby Company  
 \_\_\_\_\_ Contractor

**COMPLETED**

**SECTION PLAT**

1 Ft. from N. Line  
330 Ft. from S. Line  
 \_\_\_\_\_ Ft. from E. Line  
330 Ft. from W. Line

		0	

Location \_\_\_\_\_

Rig up \_\_\_\_\_

Drilling and Remarks:

*2000 Acid*

*Pat-1817*

**RECORD**

Cased 6 in., 3283 ft.

Sand 511 3283

Gas \_\_\_\_\_

Oil \_\_\_\_\_

Total Depth 5298

**PRODUCTION**

1st 24 hrs. Nat. \_\_\_\_\_

1st 24 hrs. after shot \_\_\_\_\_

Gas \_\_\_\_\_ Cu. Ft.

Dry Hole \_\_\_\_\_

Abandoned \_\_\_\_\_

Date

SEP 1 1937 19

H. D. Hatfield Scout