


Section 3 Township 17 Range 11-W

Well No. #1 Radenberg

Company Brook Pierce  
Kraft-prusa Pool

NORTH

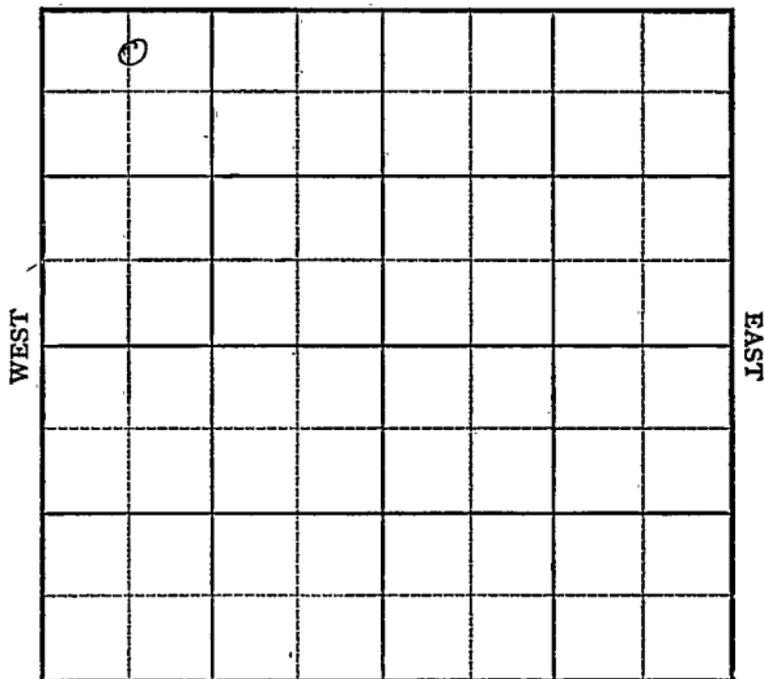

SOUTH

Sec. 3 Twp. 17 R. 11W

Well No. #1 Radenberg Farm

Brook Pierce Company


Brook Pierce Contractor

Kraft-Prusa Pool  
330' Ft. from N. Line

\_\_\_\_\_ Ft. from S. Line

\_\_\_\_\_ Ft. from E. Line

660' Ft. from W. Line

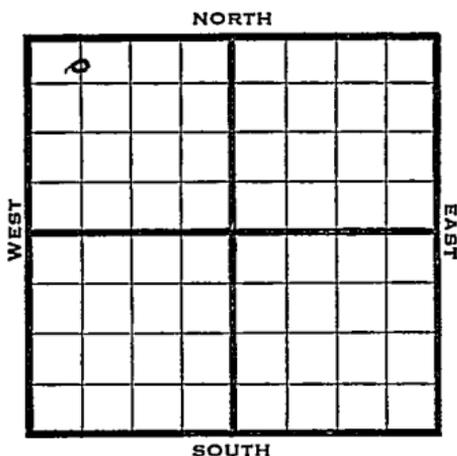

C N L NW NW

1949 Elev 1920' REPORT

11/9	Location
11/16	8" @ 225'
11/23	Lansing 3075' Drlg 3126'
11/29	Arb. 3378-82' TD 3382( 5" @ 3378'
12/7	2400' oil 4 hrs.
12/14	"
12/21	"
12/28	"
1950	
2/1	TD 3382' 8" @ 225' 5" @ 3378' Lans 3075' Arb. 3378' P 190 BOPD Comp

**COMPLETED**

Map No. \_\_\_\_\_ Sec. 3 Twp. 17 R. 11W

Well No. 1 Radenberg

Brook Pierce Company

Brook Pierce Contractor

**FIRST REPORT  
SECTION PLAT**

C N L NW NW

330 Ft. from N. Line

\_\_\_\_\_ Ft. from S. Line

\_\_\_\_\_ Ft. from E. Line

660 Ft. from W. Line

o			

Barton County

Location X

Rig up \_\_\_\_\_

Drilling and Remarks: \_\_\_\_\_

**RECORD**

Cased \_\_\_\_\_ in., \_\_\_\_\_ ft.

Sand \_\_\_\_\_

Gas \_\_\_\_\_

Oil \_\_\_\_\_

Total Depth \_\_\_\_\_

**PRODUCTION**

1st 24 hrs. Nat. \_\_\_\_\_

1st 24 hrs. after shot \_\_\_\_\_

Gas \_\_\_\_\_ Cu. Ft.

Dry Hole \_\_\_\_\_

Abandoned \_\_\_\_\_

Date

NOV 9 1949 19


S. J. LEWIS Scout

Kansas

Kraft-Prusa Pool

Map No. \_\_\_\_\_ Sec. 3 Twp. 17 R. 11WWell No. 1 Radenberg\_\_\_\_\_  
Brook Pierce Company\_\_\_\_\_  
Contractor

C N L NW NW

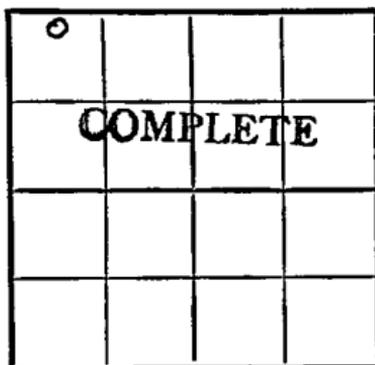E. 1920  
SECTION PLAT330 Ft. from N. Line\_\_\_\_\_  
Ft. from S. Line\_\_\_\_\_  
Ft. from E. Line660 Ft. from W. Line

Barton County

Location \_\_\_\_\_

Rig up \_\_\_\_\_

Drilling and Remarks:

8" @ 225

5" @ 3378

Lans 3075

and 3378

P 190 BOPD

C

## RECORD

Cased \_\_\_\_\_ in., \_\_\_\_\_ ft.

Sand \_\_\_\_\_

Gas \_\_\_\_\_

Oil \_\_\_\_\_

Total Depth 3382

## PRODUCTION

1st 24 hrs. Nat. \_\_\_\_\_

1st 24 hrs. after shot \_\_\_\_\_

Gas \_\_\_\_\_ Cu. Ft.

Dry Hole \_\_\_\_\_

Abandoned \_\_\_\_\_

Date

FEB 1 1950

19

J. E. TYRA

Scout