

KANSAS

Form 51-5M-7-40-Palace

Barton


Section 2 Township 17 Range 11-W

Well No. #3 Burmeister "A"

Company Texas

NORTH Kraft Pool

//

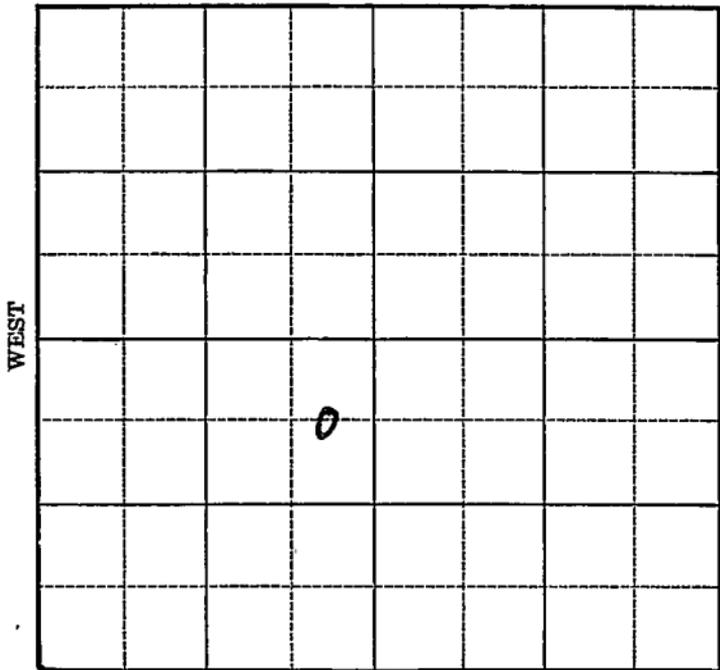

SOUTH

Form 26-200 Bks.--1-40--Palace Barton

KANSAS

Map No. 55 Sec. 2 Twp. 17 R. 11W

Well No. 3 Burmeister "A"

Texas

Company _____

Contractor _____

FIRST REPORT

SECTION PLAT

C E L N E S W

660 Ft. from N. Line

_____ Ft. from S. Line

330 Ft. from E. Line

_____ Ft. from W. Line

KRAFT POOL

	0		

Location X

Rig up _____

Drilling and Remarks:

RECORD

Cased _____ in., _____ ft.

Sand _____

Gas _____

Oil _____

Total Depth _____

PRODUCTION

1st 24 hrs. Nat. _____

1st 24 hrs. after shot _____

Gas _____ Cu. Ft.

Dry Hole _____

Abandoned _____

Date

DEC 4 1940 19

S. J. LEWIS Scout

Map No. 55 Sec. 2 Twp. 17 R. 11WWell No. 3 Burmeister "A"

Texas

Company

Contractor

ABANDONED

C E L N E SW

660 Ft. from N. Line

_____ Ft. from S. Line

330 Ft. from E. Line

_____ Ft. from W. Line

KRAFT POOL

SECTION PLAT

Location _____

Rig up _____

Drilling and Remarks:

*Cor 3392**Noe know.***RECORD**

Cased _____ in., _____ ft.

Sand _____

Gas _____

Oil _____

Total Depth 3396**PRODUCTION**

1st 24 hrs. Nat. _____

1st 24 hrs. after shot _____

Gas _____ Cu. Ft.

Dry Hole _____

Abandoned _____

Date

DEC 23 1940 19S. J. LEWIS

Scout