

KANSAS


Barton

FORM 51 5M 10-41 PETROL

Section 24 Township 17 Range 11-W

Well No. #3 Burmeister "B"

Company Texas

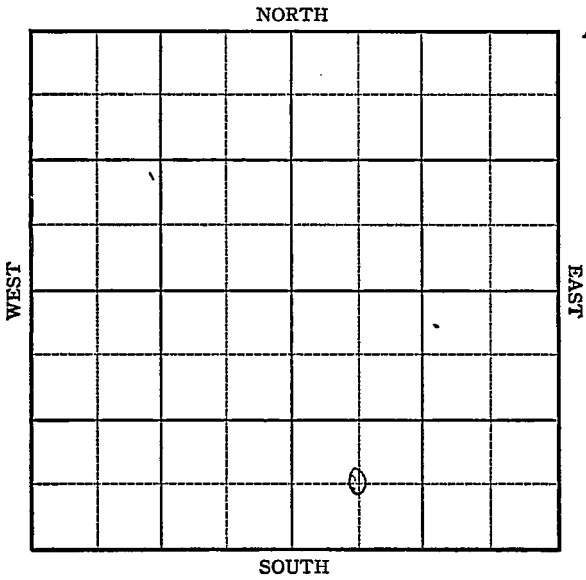

KANSAS

Barton

Sec. 2 Twp. 17 R. 11-W

Well No. #3 Burmeister "B" Farm

Texas Company

Kraft Prusa


 Ft. from N. Line

660 Ft. from S. Line

 Ft. from E. Line

660 Ft. from W. Line

Elev. 1939

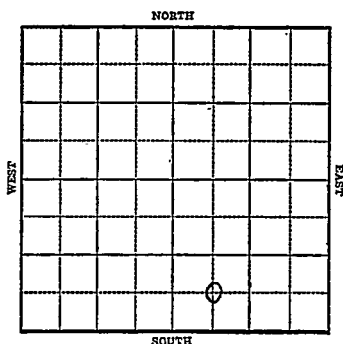

1943

R E P O R T

2/24 Location.
3/3 8" Casing set 295
Topeka 2665
Drlg. 2800
3/10 Lans 3062-67
Congl 3354 3064 300.
Arb 3372
TD 3374 SO
5" Casing set 3372' RUST
3/16 T.D. 3382-2800' oil 24 hrs.
3/24 T.D. ~~3386~~ No Inc in oil
3/31 Arb 3372
5" @ 3372
Pump 527 Pot. Gr. 42
T.D. 3386'

COMPLETED

KANSAS

Map No. 3-5 Sec. 2 Twp. 17 R. 11WWell No. 3 Burmeister "B"Texas

Company

FIRST REPORT

Contractor

C SW SE

SECTION PLAT

		0	

 Ft. from N. Line660 Ft. from S. Line Ft. from E. Line660 Ft. from W. LineKRAFT PRUSA POOLLocation XXXRig up

Drilling and Remarks:

RECORD

Cased in., ft.Sand Gas Oil Total Depth

PRODUCTION

1st 24 hrs. Nat. 1st 24 hrs. after shot Gas Cu. Ft.Dry Hole Abandoned

Date

FEB 24 1943

19

S. J. LEWIS Scout

Barton

KANSAS

Map No. 35 Sec. 2 Twp. 17 R. 11WWell No. 3 Burmeister "B"

Texas

Company

COMPLETED

Contractor

C SW SE

SECTION PLAT

		0	

Ft. from N. Line

660

Ft. from S. Line

Ft. from E. Line

660

Ft. from W. Line

KRAFT PRUSA POOL

Location

Rig up

Drilling and Remarks:

*Per 3372**5" 3372**Pump 527 P.D.**42 E*

RECORD

Cased in., ft.

Sand

Gas

Oil

Total Depth 3372

PRODUCTION.

1st 24 hrs. Nat. 1st 24 hrs. after shot Gas Cu. Ft.Dry Hole Abandoned

Date

MAR 31 1943

19

S. J. LEWIS

Scout