


Barton KANSAS

Section 2 Township 17 Range 11W

Well No. 5 Burmeister "A"

Company Texas

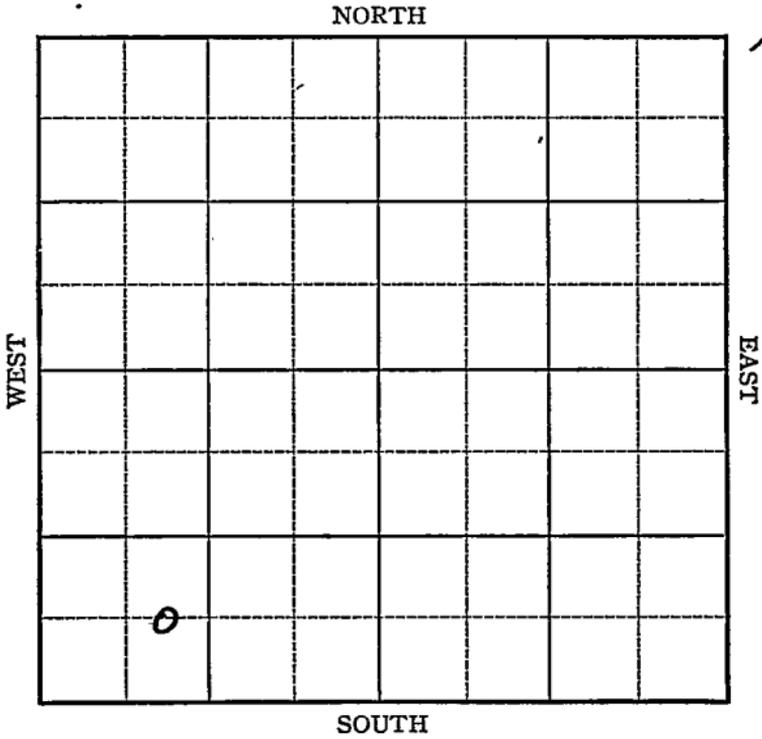

Sec. 2 Twp. 17 R. 11-W

Well No. #5 Burmeister "A" Farm

Texas Company

(Kraft)


\_\_\_\_\_ Ft. from N. Line

660 Ft. from S. Line

\_\_\_\_\_ Ft. from E. Line

990 Ft. from W. Line

Elev. 1909

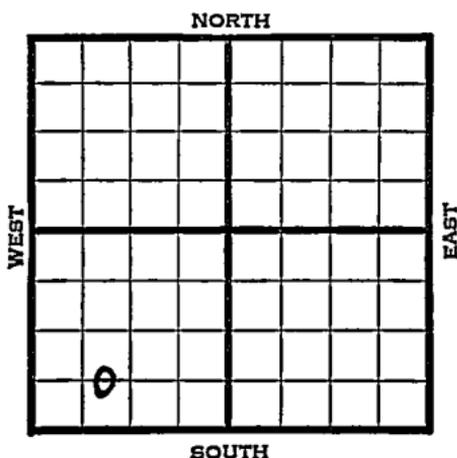

1941	REPORT
6/11	Derrick.
6/19	10" - 272' Drlg. 2702'
6/26	Arb. 3326' 7" - 3326'
	T.D. 3340' 3100' oil.
7/1	Arb. 3326'
	7" - 3326'
	T.D. 3340'
	Depthograph potential 4023 bbls.
	Maximum 3000 bbls.
	43.6 Gravity
	<b>COMPLETED</b>

Map No. 55 Sec. 2 Twp. 17 R. 11WWell No. 5 Burmeister "A"

Texas

Company

Contractor

~~FIRST REPORT~~

## SECTION PLAT

C E L SW SW

\_\_\_\_\_ Ft. from N. Line

660 Ft. from S. Line

\_\_\_\_\_ Ft. from E. Line

990 Ft. from W. Line


KRAFT POOL

Location \_\_\_\_\_

Rig up \_\_\_\_\_

Drilling and Remarks:

Derrick

## RECORD

Cased \_\_\_\_\_ in., \_\_\_\_\_ ft.

Sand \_\_\_\_\_

Gas \_\_\_\_\_

Oil \_\_\_\_\_

Total Depth \_\_\_\_\_

## PRODUCTION

1st 24 hrs. Nat. \_\_\_\_\_

1st 24 hrs. after shot \_\_\_\_\_

Gas \_\_\_\_\_ Cu. Ft.

Dry Hole \_\_\_\_\_

Abandoned \_\_\_\_\_

Date

JUN 11 1941

19

S. J. LEWIS

Scout

Map No. \_\_\_\_\_ Sec. 2 Twp. 17 R. 11WWell No. 5 Burmeister "A"

Texas

Company

COMPLETED

Contractor

## SECTION PLAT

C E L SW SW

\_\_\_\_\_ Ft. from N. Line

660 Ft. from S. Line

\_\_\_\_\_ Ft. from E. Line

990 Ft. from W. Line


KRAFT POOL

## RECORD

Location \_\_\_\_\_

Cased \_\_\_\_\_ in., \_\_\_\_\_ ft.

Rig up \_\_\_\_\_

Sand \_\_\_\_\_

Drilling and Remarks:

Gas \_\_\_\_\_

Oil \_\_\_\_\_

*Cor 3326**7" @ 3326.**Depth 4823**Flow 3000*Total Depth 3340

## PRODUCTION

1st 24 hrs. Nat. \_\_\_\_\_

1st 24 hrs. after shot \_\_\_\_\_

Gas \_\_\_\_\_ Cu. Ft.

Dry Hole \_\_\_\_\_

Abandoned \_\_\_\_\_

*436 Gr*

Date

JUL 1 1941 19S. J. LEWIS Scout