


Section 10 Township 19 Range 15W

Well No. #2 F. Seeber

Company Hekneruck & Payne

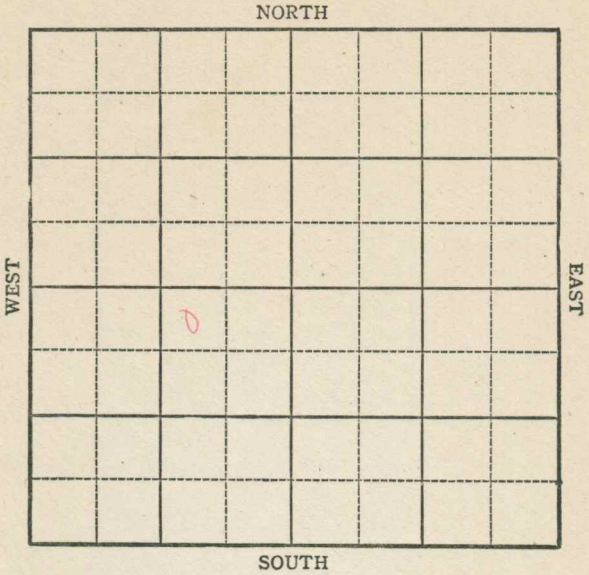

KANSAS

Barton County

Sec. 10 Twp. 19 R. 15W

Well No. #2 F. Seeber Farm


Helmerick & Payne Company

Mertens
330 Ft. from N. Line

Ft. from S. Line

990 Ft. from E. Line

Ft. from W. Line

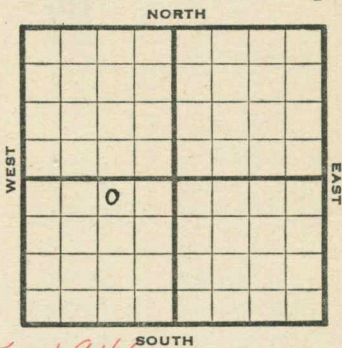

NW NE SW

Elev. 1941

1944

R E P O R T

12/13

RUR

12/21

"

12/29

"

1945

1/3

"

1/10

"

1/17

"

1/26

RUR

1/31

Surface hole

2/7

Anhy 888

10" @ 899

Drlg 1725

2/14

Drlg 3045

2/21

Lans 3240

Cong 3496

Reagan 3530

TD 3541 - 5" @ 3534 RUST

2/28

" " " " " "

3/7

" " " " " "

3/14

" " " " " "

3/23

TD 3550' Est. flow 15 oil per hr

3/29

" " " " " "

4/5

" " " " " "

4/12

" " " " " "

OVER

1945

4/20 TD 3550' Est flow 15 oil per hr.
4/27 " " " " " " " " "

5/2 Reagan 3530

5" @ 3534

TD 3550

Flow 450 Pot.

Grav. 35.8

COMPLETED

Pool Name Mertens

Map No. 82 Sec. 10 Twp. 19 R. 15W

Well No. 2 F. Seeber

Helmerick & Payne Company

FIRST REPORT

Contractor

NW NE SW

SECTION PLAT

330 Ft. from N. Line

_____ Ft. from S. Line

990 Ft. from E. Line

_____ Ft. from W. Line

	o		

Barton

Location _____

Rig up _____

Drilling and Remarks:

R U R

RECORD

Cased _____ in., _____ ft.

Sand _____

Gas _____

Oil _____

Total Depth _____

PRODUCTION

1st 24 hrs. Nat. _____

1st 24 hrs. after shot _____

Gas _____ Cu. Ft.

Dry Hole _____

Abandoned _____

Date

DEC 13 1944 19

S. J. LEWIS

Scout

Kansas Pool Name Mertens

Map No. 82 Sec. 10 Twp. 19 R. 15W

Well No. 2 F. Seeber

Helmerick & Payne Company

COMPLETED

Contractor

NW NE SW

E 1, 1941
SECTION PLAT

330 Ft. from N. Line

_____ Ft. from S. Line

990 Ft. from E. Line

_____ Ft. from W. Line

	o		

MC

Barton County

Location _____

Rig up _____

Drilling and Remarks:

Reagan 3530
5' 3534
Flow 450 P.D.

35 5/8

RECORD

Cased _____ in., _____ ft.

Sand _____

Gas _____

Oil _____

Total Depth 3530

PRODUCTION

1st 24 hrs. Nat. _____

1st 24 hrs. after shot _____

Gas _____ Cu. Ft.

Dry Hole _____

Abandoned _____

Date

MAY 2 1945 19

S. J. LEWIS Scout